

Pearl River

L 36

1-12-73

MISSISSIPPI  
BOARD OF WATER COMMISSIONERS  
416 North State Street  
Jackson, Mississippi 39201

**CODED**

WATER WELL DRILLERS LOG

Jan. 12 1973  
date well completed

B. Woodward Drilling  
firm name

Pearl River  
county well located

LANDOWNER:

Cleanance Pier  
(Present address)

Motarie, La. 70001  
(mailing address)

description of formations encountered

from

to

yellow clay

2

16'

sand at small grain

16

43'

blue clay

43

90'

good sand

90

170'

WELL LOCATION:

sec. 30 T. 3 N. R. 16 W. E. S. #  
2 1/2 miles West of Derby  
(distance) (direction) (nearest town)

WELL PURPOSE:

Home  
(home, irrigation, municipal, industrial)

WELL COMPLETION DATA:

(1) diameter (inches) 2"

(2) total depth (feet) 170'

(3) static water level (feet) 2 <sup>below</sup> above top of ground.

(4) casing 40 PVC 165'  
(material) (depth)

2"  
(size) if telescope see back.

(5) screen 5' 165'  
(length) (depth to top)

2" x 15 PVC  
(size) (material)

(6) pump None  
(HP) (yield gpm)

(type power)

(7) electric log NO  
(yes or no)

(organization running log)

(8) how well bottom plugged float-type  
backwash valve


DRILLERS REMARKS:

**CODED**

**1973**

If well telescopes please sketch and show depths.

GROUND LEVEL

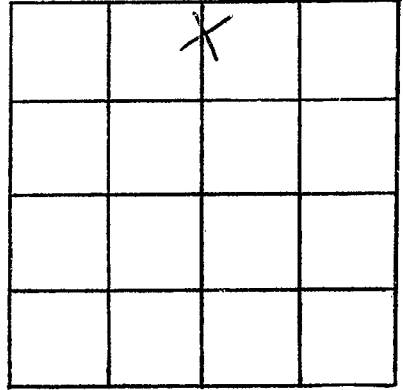

SECTION 30

Please indicate well location X.

ADDITIONAL INFORMATION

If more than one screen,  
show locations of each on sketch.