

Pearl River
L 39
7-2-73

MISSISSIPPI
BOARD OF WATER COMMISSIONERS
416 North State Street
Jackson, Mississippi 39201

CODED

WATER WELL DRILLERS LOG

7-2 1973 Herbert A. Poole Pearl River
date well completed firm name county well located

LANDOWNER: <u>J. M. Geer Sr.</u>	description of formations encountered	from	to
<u>Poplarville</u> (mailing address)	<u>Surface Clay</u>	<u>0</u>	<u>10</u>
	<u>Sand & Clay</u>	<u>10</u>	<u>20</u>
	<u>CLAY</u>	<u>20</u>	<u>60</u>
	<u>Silt</u>	<u>60</u>	<u>76</u>
	<u>SAND</u>	<u>76</u>	<u>95</u>

WELL LOCATION:
sec. 11 T. 3 N. R. 16 E.
4 miles So of Poplarville
(distance) (direction) (nearest town)

WELL PURPOSE:
(home, irrigation, municipal, industrial)

WELL COMPLETION DATA:

(1) diameter (inches) 4 1/4

(2) total depth (feet) 94 ft

(3) static water level (feet) 60 below top of ground.

(4) casing PVC 89
(material) (depth)

2"
(size) If telescope see back.

(5) screen 5 89
(length) (depth to top)

2" 0.10 PVC
(size) (material)

(6) pump 1 4
(HP) (yield gpm)

Clear
(type power)

(7) electric log No
(yes or no)

(organization running log)

(8) how well bottom plugged By Valve


CODED

DRILLERS REMARKS:

AUG 3 1973

If well telescopes please
sketch and show depths.

GROUND LEVEL

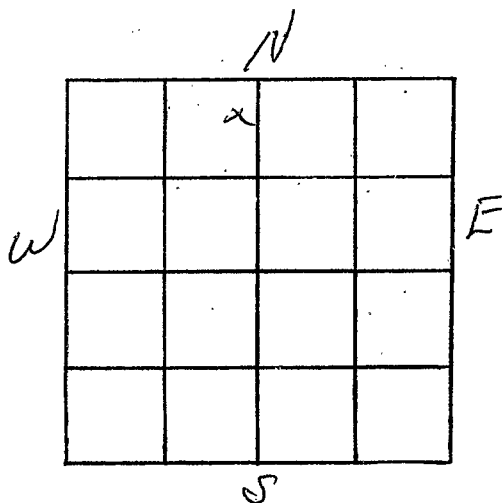

SECTION 11

Please indicate well location X.

ADDITIONAL INFORMATION

If more than one screen,
show locations of each on sketch.