

P. R.  
L 42  
4-8-74

MISSISSIPPI  
BOARD OF WATER COMMISSIONERS  
416 North State Street  
Jackson, Mississippi 39201

WATER WELL DRILLERS LOG **CODED**

4-8 date well completed 1974 LUMPKIN Well Ser firm name Pearl River county well located

LANDOWNER: Southland Dev. Co.

Carrier, Miss.  
(mailing address)

WELL LOCATION:  
sec. 9 T S N R 16 E  
2 1/2 miles East of Carrier  
(distance) (direction) (nearest town)

WELL PURPOSE: Home  
(home, irrigation, municipal, industrial)

- WELL COMPLETION DATA:
- (1) diameter (inches) 2"
  - (2) total depth (feet) 220'
  - (3) static water level (feet) 30 below above top of ground.
  - (4) casing P.V.C., 215,  
(material) (depth)  
2"  
(size) If telescope see back.
  - (5) screen 5, 215'  
(length) (depth to top)  
2", P.V.C.  
(size) (material)
  - (6) pump 1/2 600 P.h.  
(HP) (yield gpm)  
Elec.  
(type power)
  - (7) electric log No  
(yes or no)
  - (organization running log)
  - (8) how well bottom plugged Sand Shrub


description of formations encountered	from to	
Clay	0	90
Sand	90	120
Clay	120	180
Sand	180	220
<b>CODED</b>		

DRILLERS REMARKS:

JUN 25 1974  
MISS. Bd. OF WATER COMMISSIONERS

If well telescopes please sketch and show depths.

GROUND LEVEL

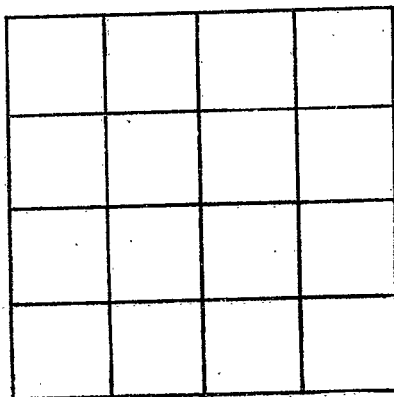

SECTION \_\_\_\_\_

Please indicate well location X.

ADDITIONAL INFORMATION

If more than one screen,  
show locations of each on sketch.