

Pearl River  
L 43  
6-25-74

MISSISSIPPI  
BOARD OF WATER COMMISSIONERS CODED  
416 North State Street  
Jackson, Mississippi 39201

WATER WELL DRILLERS LOG

6-25-74 19 Dauphin Well Ser. Pearl River  
date well completed firm name county well located

LANDOWNER: Bert Miller  
Dauphin Island, Ala.  
(mailing address)

description of formations encountered	from	to
Clay	0	30
Sand	30	50
Clay	50	180
Sand	180	206


WELL LOCATION:  
sec. 31 T 3 N R 76 E  
4 miles West of Derby  
(distance) (direction) (nearest town)

WELL PURPOSE: Home  
(home, irrigation, municipal, industrial)

- WELL COMPLETION DATA:
- (1) diameter (inches) 2"
  - (2) total depth (feet) 206'
  - (3) static water level (feet) 2" below above top of ground.
  - (4) casing P.V.C. 200'  
(material) (depth)  
2" If telescope see back.  
(size)
  - (5) screen 6' 200'  
(length) (depth to top)  
2" P.V.C.  
(size) (material)
  - (6) pump 1/2 350  
(HP) (yield gpm)  
Elec.  
(type power)
  - (7) electric log No  
(yes or no)

CODED

(organization running log)  
(8) how well bottom plugged Sand Shrub

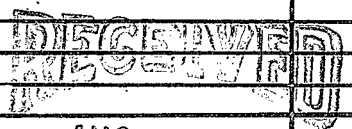


AUG - 8 1974

DRILLERS REMARKS:

If well telescopes please sketch and show depths.

GROUND LEVEL

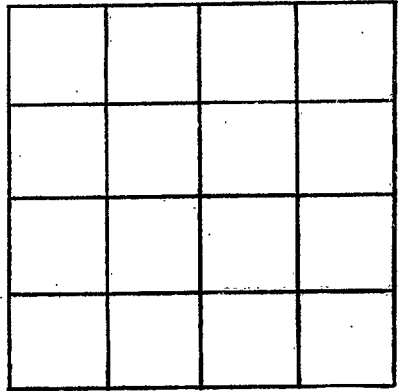

SECTION \_\_\_\_\_

Please indicate well location X.

ADDITIONAL INFORMATION

If more than one screen, show locations of each on sketch.