

P. R.
L45
11-30-74

MISSISSIPPI
BOARD OF WATER COMMISSIONERS
416 North State Street
Jackson, Mississippi 39201

CODED

WATER WELL DRILLERS LOG

11-30 date well completed. 1974 Lumphin Well Dr. Paul Riner firm name Paul Riner county well located

LANDOWNER: Larry Springs
Rt. Poplarville, Miss
(mailing address)

description of formations encountered	from	to
Clay	0	1.5
Sand	1.5	4.5
Clay	4.5	5.0
Sand	5.0	8.5

WELL LOCATION:
sec. 7 T. 3 N. R. 16 E.
6 miles West of Poplarville
(distance) (direction) (nearest town)

WELL PURPOSE: Home
(home, irrigation, municipal, industrial)

WELL COMPLETION DATA:

(1) diameter (inches) 2"

(2) total depth (feet) 8.5

(3) static water level (feet) 55' below above top of ground.

(4) casing P.V.C. 80',
(material) (depth)
2" if telescope see back.
(size)

(5) screen 5', 80'
(length) (depth to top)
2", P.V.C.
(size) (material)


(6) pump 1/2, 400 S.P.H.
(HP) (yield gpm)
Elec.
(type power)

(7) electric log No.
(yes or no)

(organization running log)

(8) how well bottom plugged Sand Shovel

CODED

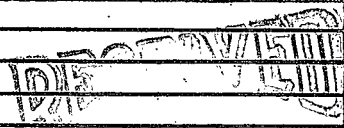


IAN 22 1975

R CO

DRILLERS REMARKS:

If well telescopes please sketch and show depths.

GROUND LEVEL

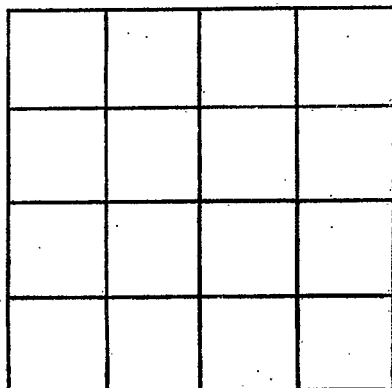

SECTION _____

Please indicate well location X.

ADDITIONAL INFORMATION

If more than one screen,
show locations of each on sketch.