

Pearl River
 L 46
 6-2-75

MISSISSIPPI
 BOARD OF WATER COMMISSIONERS
 416 North State Street
 Jackson, Mississippi 39201

CODED

WATER WELL DRILLERS LOG

6-2 1975 Lumpkins Well Ser. Pearl River
 date well completed firm name county well located

LANDOWNER:
Mr. Euell Hest
Rt. Poplarville, Ms.
 (mailing address)

WELL LOCATION:
 sec. 19 T. 3 N. R. 16 E. 33 V
4 miles West of Derby
 (distance) (direction) (nearest town)

WELL PURPOSE: Home
 (home, irrigation, municipal, industrial)

- WELL COMPLETION DATA:
- (1) diameter (inches) 4"
 - (2) total depth (feet) 385'
 - (3) static water level (feet) 75' below top of ground.
 - (4) casing P.V.C., 375'
 (material) (depth)
4" if telescope see back.
 (size)
 - (5) screen 10', 375'
 (length) (depth to top)
4", P.V.C.
 (size) (material)
 - (6) pump He Installed
 (HP) (yield gpm)
Pump Elec.
 (type power)
 - (7) electric log No
 (yes or no)
No
 (organization running log)
 - (8) how well bottom plugged Sand Shrub

description of formations encountered	from	to
Clay	0	15
Sand	15	25
Clay	25	60
Sand	60	100
Clay	100	165
Sand	165	188
Clay	188	210
Sand	210	255
Clay	255	335
Sand	335	385


DRILLERS REMARKS:

RECEIVED
 JUL 14 1975

MISS. BD. OF WATER COMMISSIONERS

If well telescopes please sketch and show depths.

GROUND LEVEL

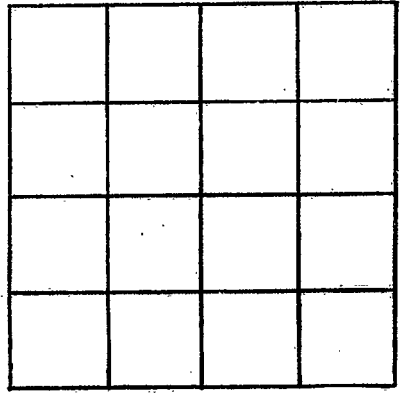

SECTION _____

Please indicate well location X.

ADDITIONAL INFORMATION

A series of horizontal lines providing space for additional information.

If more than one screen, show locations of each on sketch.