

MISSISSIPPI DEPARTMENT OF NATURAL RESOURCES

Bureau of Land and Water Resources

Southport Mall

P.O. Box 10631

Jackson, Mississippi 39209

WATER WELL DRILLERS LOG

CODED

L49
PEARL RIVER
5-23-84

5-23-84

Griner Drilling Service, Inc.

Pearl River

date well completed

firm name

county well located

LANDOWNER:

description of formations encountered

from

to

EXXON Company, U.S.A.
P.O. Box 61812
New Orleans, La. 70161
(mailing address)

Sand, gravel

0 189

clay

189 231

WELL LOCATION: 1500'S + 2030'E

Sand

231 249

No. 1 Sec. 8 T. 3 N. R. 16 E. of Poplarville
Bateson Co. (distance) (direction) (nearest town)

clay

249 370

WELL PURPOSE: Oilfield supply
(home, irrigation, municipal, industrial)

Sand, red gravel

370 470

WELL COMPLETION DATA:

clay

470 483

No. 1 Water Well
(1) diameter (inches) 4"
total depth (feet) 483'
static water level (feet) 60' below top of ground.

(4) casing steel 462' (material) (depth)

4" (size) if telescope see back.

(5) screen 40' 422' (length) (depth to top)

4" stainless (size) (material)

(6) pump 5HP 80 (HP) (yield gpm)

AE 230 volt (type power) 3 phase

(7) electric log NO (yes or no)

(organization running log)

(8) how well bottom plugged 4" wood backwash plug valve

DRILLERS REMARKS:


MISSISSIPPI DEPARTMENT OF NATURAL RESOURCES
BUREAU OF LAND & WATER RESOURCES

JUN - 4 1984

RECEIVED

If well telescopes please sketch and show depths.

GROUND LEVEL

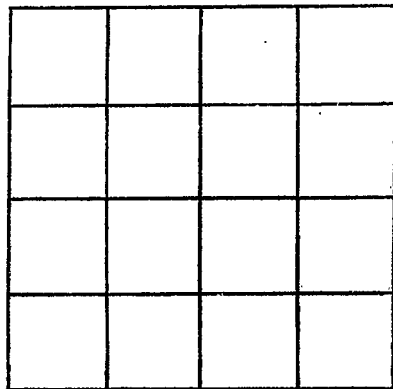

SECTION _____

Please indicate well location X.

ADDITIONAL INFORMATION

If more than one screen,
show locations of each on sketch.