

MISSISSIPPI DEPARTMENT OF NATURAL RESOURCES

Bureau of Land and Water Resources

Southport Mall

P.O. Box 10631

Jackson, Mississippi 39209

CODED

WATER WELL DRILLERS LOG

Griner Drilling Service, Inc.

Pearl River

L50  
PEARL RIVER  
5-23-84

5-23-84 date well completed

Griner Drilling Service, Inc. firm name

Pearl River county well located

LANDOWNER:

EXXON Company U.S.A.  
P.O. Box 61812  
New Orleans, La. 70161  
(mailing address)

description of formations encountered

from

to

Sand, gravel

0 189

CLAY

189 231

SAND

231 249

CLAY

249 370

SAND, pea gravel

370 462

470

WELL LOCATION: 1500 S + 2030 E

No. 8 T 3 N R 16 NW  
Batson (distance) miles (direction) of (nearest town) Cor  
McGehee, La. (distance) miles (direction) of (nearest town) Papbrville

WELL PURPOSE: vitfield supply  
(home, irrigation, municipal, industrial)

WELL COMPLETION DATA:

2nd Water Well  
(1) diameter (inches) 4"  
(2) total depth (feet) 462'  
(3) static water level (feet) 60' below top of ground.

(4) casing Steel, 462' (material) (depth)

4" (size) If telescope see back.

(5) screen 42' 420' (length) (depth to top)

4" perforated (size) (material)

(6) pump - 75-90 (HP) (yield gpm)

AC (type power)

(7) electric log (yes or no)

(organization running log)

(8) how well bottom plugged Orange peel

DRILLERS REMARKS:


DEPT. OF NATURAL RESOURCES  
BUREAU OF LAND & WATER RESOURCES

JUN - 4 1984

RECEIVED

If well telescopes please sketch and show depths.

GROUND LEVEL

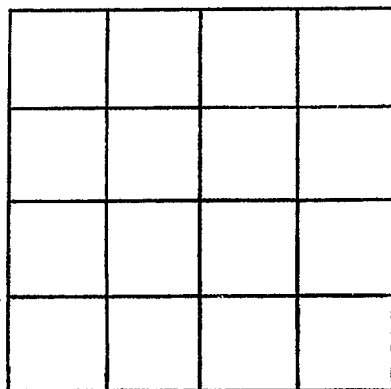

SECTION \_\_\_\_\_

Please indicate well location X.

ADDITIONAL INFORMATION

If more than one screen,  
show locations of each on sketch.