

MISSISSIPPI DEPARTMENT OF NATURAL RESOURCES

Bureau of Land and Water Resources

Southport Mall

P.O. Box 10631

CODED

Jackson, Mississippi 39209

WATER WELL DRILLERS LOG

Griner Drilling Service, INC.

Pearl River

252
PEARL RIVER
12-5-84

12-5-84
date well completed

firm name

county well located


LANDOWNER:	description of formations encountered	from	to
EXXON COMPANY U.S.A. P.O. Box 2350 New Orleans, La. 70176 (mailing address)	SAND, CLAY	0	120
WELL LOCATION: 1500'S + 1500'E sec. 16 T. 3 N. R. 16 E. NW No. 1 Poplar St. for Bd. of Trustees (distance) (direction) (nearest town)	SAND, black pea gravel	120	250
WELL PURPOSE: oilfield supply (home, irrigation, municipal, industrial)	CLAY	250	252
WELL COMPLETION DATA:			
NO. 2 diameter (inches) 4"			
NO. 2 WATER WELL total depth (feet) 252'			
(3) static water level (feet) 70' ^{below} above top of ground.			
(4) casing steel 252' (material) (depth) 4" if telescope see back. (size)			
(5) screen 42' 210' (length) (depth to top) 4" perforated (size) (material)			
(6) pump — 70 (HP) (yield gpm) AC (type power)			
(7) electric log <u>yes</u> (yes or no) (organization running log)			
(8) how well bottom plugged Orange peel			
DRILLERS REMARKS:			

CODED

peel 250
1-7-84

If well telescopes please sketch and show depths.

GROUND LEVEL

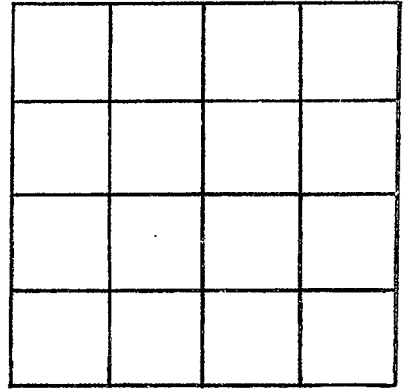

SECTION _____

Please indicate well location X.

ADDITIONAL INFORMATION

If more than one screen,
show locations of each on sketch.