

MISSISSIPPI DEPARTMENT OF NATURAL RESOURCES

Bureau of Land and Water Resources

Southport Mall

P.O. Box 10631

Jackson, Mississippi 39209

WATER WELL DRILLERS LOG

PEARL RIVER
L 56

CODED

10-17-85 Griner Drilling Service, Inc. PEARL RIVER
date well completed firm name county well located

LANDOWNER:	description of formations encountered	from	to
<u>Exxon Corporation</u> <u>P.O. Box 61001</u> <u>New Orleans, La.</u> (mailing address)			
<u>WELL LOCATION: 1500'S + 1500'E</u>	<u>streaked clay</u>	<u>150</u>	<u>310</u>
sec. <u>5</u> T. <u>3</u> N. R. <u>16</u> E. of <u>NO. 1 PODIARVILLE FIELD</u>	<u>BIG SAND</u>	<u>310</u>	<u>400</u>
<u>NO. 1 WATER WELL</u>			
<u>WELL PURPOSE: oilfield supply</u>			

WELL COMPLETION DATA:

(1) diameter (inches) 4"

(2) total depth (feet) 400'

(3) static water level (feet) 25' below above top of ground.

(4) casing steel 400'
(material) (depth) 5'

4"
(size) if telescope see back.

(5) screen 42' 358'
(length) (depth to top)

4" perforated
(size) (material)

(6) pump — 85-90
(HP) (yield gpm)

AC
(type power)

(7) electric log (yes or no)

(8) how well bottom plugged orange peel


CODED

RECEIVED
NOV 16 1985
BUREAU OF LAND & WATER RESOURCES

DRILLERS REMARKS: _____

If well telescopes please sketch and show depths.

GROUND LEVEL

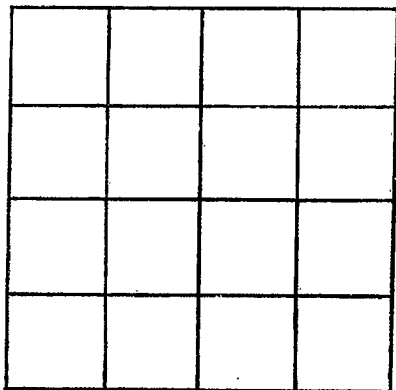

SECTION _____

Please indicate well location X.

ADDITIONAL INFORMATION

If more than one screen, show locations of each on sketch.