

MISSISSIPPI DEPARTMENT OF NATURAL RESOURCES

Bureau of Land and Water Resources

Southport Mall

P.O. Box 10631

Jackson, Mississippi 39209

WATER WELL DRILLERS LOG

DUED

PEARL RIVER
L 57

Griner Drilling Service, Inc.

Pearl River

date well completed

firm name

county well located

6-15-86

LANDOWNER:
EXXON COMPANY USA
P.O. Box 60006
New Orleans, La 70160
(mailing address)

description of formations encountered	from	to
<u>clay, SAND</u>	<u>0</u>	<u>20</u>
<u>sand, pea gravel</u>	<u>20</u>	<u>130</u>
<u>CLAY</u>	<u>130</u>	<u>330</u>
<u>sand, pea gravel</u>	<u>330</u>	<u>360</u>
<u>streaked sand, clay</u>	<u>360</u>	<u>378</u>

CODED


WELL LOCATION: 2121 S & 2223'
sec. 6 T. 3 N. R. 16 E of
Poplarville Field
(direction) (nearest town)

WELL PURPOSE: oilfield rig
supply
(home, irrigation, municipal, industrial)

WELL COMPLETION DATA:

- (1) diameter (inches) 4"
- (2) total depth (feet) 378
- (3) static water level (feet) 30' (below above top of ground)
- (4) casing steel, 378'
(material) (depth)
4"
(size) if telescope see back.
- (5) screen 42', 336'
(length) (depth to top)
4", perforated
(size) (material)
- (6) pump —, 85-90
(HP) (yield gpm)
AC
(type power)
- (7) electric log — (yes or no)

Water Well
No. 1 on
location

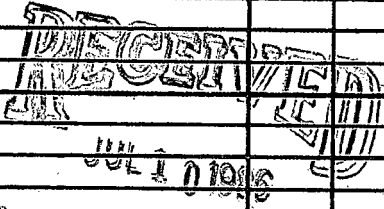

(organization running log)

(8) how well bottom plugged orange
peel

DRILLERS REMARKS:

If well telescopes please sketch and show depths.

~~02/11/11~~

GROUND LEVEL

SECTION _____

Please indicate well location X.

ADDITIONAL INFORMATION

If more than one screen,
show locations of each on sketch.