

MISSISSIPPI DEPARTMENT OF NATURAL RESOURCES

Bureau of Land and Water Resources

Southport Mall

P.O. Box 10631

Jackson, Mississippi 39209

WATER WELL DRILLERS LOG

CODED

PEARL RIVER
L 58

6-11-86

Griner Drilling Service, Inc.

Pearl River

date well completed

firm name

county well located

LANDOWNER:

EXXON COMPANY USA
P.O. BOX 60006
NEW ORLEANS, LA.

(mailing address) 70180

description of formations encountered

from

to

CLAY, SAND

0 20

SAND, pea gravel

20 130

WELL LOCATION:

21215 0006

No. 3
Southern
Mitche
et

6 T 3 N R 16 E 2223'

Parlarville Field

(direction) (nearest town)

CLAY

130 330

SAND, p. gravel

330 360

streaked sand
CLAY

360 380

WELL PURPOSE:

oilfield rig
supply

WELL COMPLETION DATA:

(1) diameter (inches) 4"

(2) total depth (feet) 380'

(3) static water level (feet) 30' ^{below} above top of ground.

(4) casing steel 360'
(material) (depth)

4"
(size) if telescope see back.

(5) screen 20' 340'
(length) (depth to top)

4" stainless
(size) (material)

(6) pump 5 75
(HP) (yield gpm)

230 volt 3 phase
(type power)

(7) electric log (yes or no)


(organization running log)

(8) how well bottom plugged 4" wood
plug-back wash
valve

DRILLERS REMARKS:

CODED

No. 2
water well
Drilled on
location

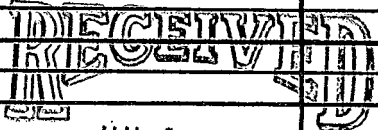


JUL 10 1986

Department of Natural Resources
Bureau of Land & Water Resources

If well telescopes please sketch and show depths.

GROUND LEVEL

CHAND

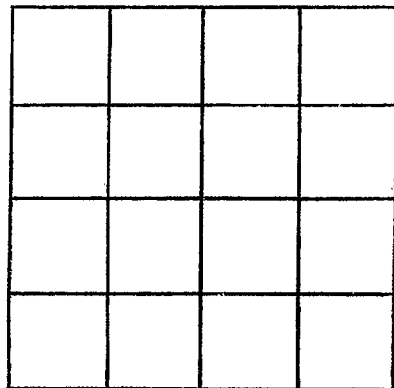

SECTION _____

Please indicate well location X.

ADDITIONAL INFORMATION

If more than one screen, show locations of each on sketch.