

MISSISSIPPI DEPARTMENT OF NATURAL RESOURCES

Bureau of Land and Water Resources

Southport Mall

P.O. Box 10631

CODED

Jackson, Mississippi 39209

WATER WELL DRILLERS LOG

Griner Drilling Service, Inc.

Pearl River

Pearl River  
L 59  
7-3-86

7-3-86 date well completed

Griner Drilling Service, Inc. firm name

Pearl River county well located

LANDOWNER:

EXXON CO., U.S.A.

P.O. Box 60006

New Orleans, La 70160  
(mailing address) 0000

description of formations encountered

from

to

sand, gravel

0

126

CLAY

126

315

WELL LOCATION:

1684' S + 187' E

sec. 6 T. 3 N. R. 16 E. of

Poplarville

Field

CLAY, SOME SAND

315

399

No. 3-A  
Southern  
Miss. State  
Camp

1 mile (direction) of  
Poplarville Field (nearest town)

CLAY

399

430

WELL PURPOSE:

oilfield rig

(home, irrigation, municipal, industrial)

streaked CODED

430

504

WELL COMPLETION DATA:

(1) diameter (inches)

4"

(2) total depth (feet)

567'

(3) static water level (feet)

80' (below above top of ground)

(4) casing

steel 567' (material) (depth)

4" (size)

if telescope see back.

(5) screen

42' 525' (length) (depth to top)

4" (size)

perforated (material)

(6) pump

90 (HP) (yield gpm)

AC (type power)

(7) electric log

(yes or no)

(organization running log)

(8) how well bottom plugged

orange

peel

DRILLERS REMARKS:

Water well No. 1


RECEIVED

OCT 17 1986

Department of Natural Resources  
Bureau of Land & Water Resources

If well telescopes please  
sketch and show depths.

GROUND LEVEL

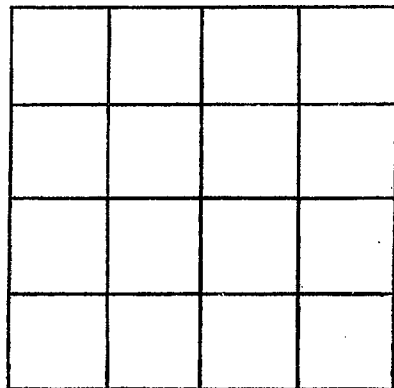

SECTION \_\_\_\_\_

Please indicate well location X.

ADDITIONAL INFORMATION

If more than one screen,  
show locations of each on sketch.