

MISSISSIPPI DEPARTMENT OF NATURAL RESOURCES

Bureau of Land and Water Resources

Southport Mall

P.O. Box 10631

Jackson, Mississippi 39209

WATER WELL DRILLERS LOG

CODED

Pearl River
 L 60.
 7-3-86

Griner Drilling
 Service, Inc.

Pearl
 River

7-3-86
 date well completed

firm name

county well located

LANDOWNER:

Exxon Co., U.S.A.
 P.O. Box 60006
 New Orleans, LA 70160
 (mailing address)

description of formations
 encountered

from

to

SAND, gravel

0 126

clay

126 315

clay, some
 sand

315 399

clay

399 430

streaked

430 504

sand

504 567

clay

567 588

WELL LOCATION: 189° 5' + 18771E

sec. 6 T-3 N R-16 E of

No. 3-A (S) of Pearl River
 3 miles (direction) of Poplarville (town)

WELL PURPOSE: oilfield
 (home, irrigation, municipal, industrial)

WELL COMPLETION DATA:

- (1) diameter (inches) 4"
- (2) total depth (feet) 588'
- (3) static water level (feet) 80' below top of ground.
- (4) casing steel, 567' (material) (depth)
 4" (size) if telescope see back.
- (5) screen 20' (length), 547' (depth to top)
 4" stainless steel (size) (material)
- (6) pump 5 (HP) 100 (yield gpm)
 230 volt 3 phase (type power)
- (7) electric log (yes or no)

Water
 well
 No. 2

RECEIVED
 RE

NOV 17 1986

(organization running log)


Department of Natural Resources
 Bureau of Land & Water Resources

- (8) how well bottom plugged 4" wood plug - backwash valve

DRILLERS REMARKS:

If well telescopes please
sketch and show depths.

GROUND LEVEL

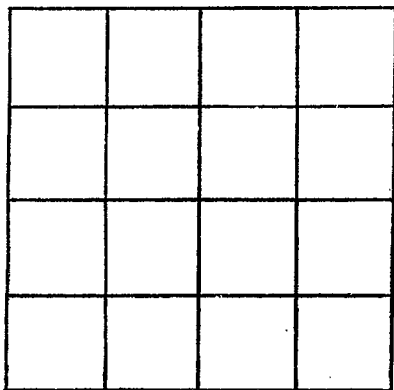

SECTION _____

Please indicate well location X.

ADDITIONAL INFORMATION

If more than one screen,
show locations of each on sketch.