

MISSISSIPPI DEPARTMENT OF NATURAL RESOURCES

Bureau of Land and Water Resources

Southport Mall

P.O. Box 10631

Jackson, Mississippi 39209

CODED

WATER WELL DRILLERS LOG

Griner Drilling Service, Inc.

Pearl River

PEARL RIVER
L 63
1-8-87

date well completed

firm name

county well located

LANDOWNER:

EXXON Company USA
P.O. Box 60006
New Orleans, LA. 70160
(mailing address) 0060

description of formations encountered

from

to

CLAY, SAND

0 210

SAND

210 240

WELL LOCATION: 1902'5" x 1693'6"

sec. 19 T. 3 N. R. 16 E. of

CLAY, SAND,
mostly clay

240 412

No. 1
Ewell D. Hill
D. Hill
miles (direction) of (nearest town)
Doplarville Field

SAND, pea gravel 412 546

WELL PURPOSE: oilfield mg.
(home, irrigation, municipal, industrial) SUPPLY

WELL COMPLETION DATA:

(1) diameter (inches) 4"

(2) total depth (feet) 546'

(3) static water level (feet) 85' below top of ground.

(4) casing steel 546' (material) (depth) 4" (size) if telescope see back.

(5) screen 20' 526' (length) (depth to top) 4" stainless (size) (material) steel

(6) pump 5 HP 75-80 (HP) (yield gpm) 230 volt 3 phase (type power) pump-motor

(7) electric log (yes or no)

(organization running log)

(8) how well bottom plugged 4" back wash valve

DRILLERS REMARKS:

CODED

No. 2
water well


RECEIVED

JAN 19 1987

Department of Natural Resources
Bureau of Land & Water Resources

If well telescopes please sketch and show depths.

GROUND LEVEL

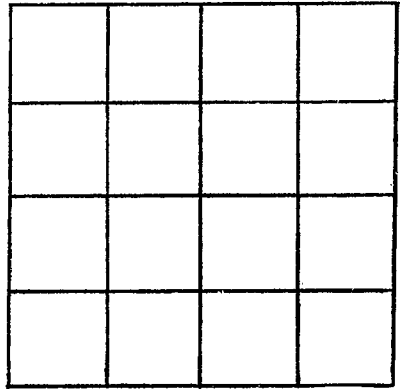

SECTION _____

Please indicate well location X.

ADDITIONAL INFORMATION

If more than one screen,
show locations of each on sketch.