

Pearl River
 L 65
 351C

MISSISSIPPI DEPARTMENT OF NATURAL RESOURCES

Bureau of Land and Water Resources

Southport Mall

P.O. Box 10631

Jackson, Mississippi 39209

WATER WELL DRILLERS LOG

Coded

2-4-88

Griner Drilling Service, Inc.

Pearl River

date well completed

firm name

county well located

LANDOWNER:

EXXON Company USA

P.O. Box 4301

Houston, Texas 77210-4301

(mailing address)

description of formations encountered

from

to

clay

0 121

sand & gravel

121 55

clay

55 100

sand & gravel

100 172

clay

172 370

sand & gravel

370 462

WELL LOCATION: 1500' N + 1893' E

sec. 7 T. 3 N. R. 16 E of

No. 1 D.O. Poplarville Field

(distance) (direction) (nearest town)

No. 2 Water Well on location

WELL PURPOSE: oilfield rig supply

(home, irrigation, municipal, industrial)

WELL COMPLETION DATA:

(1) diameter (inches) 4"

(2) total depth (feet) 462'

(3) static water level (feet) 43' ^{below} above top of ground.

(4) casing steel, 462' (material) (depth)

4" (size) if telescope see back.

(5) screen 42', 420' (length) (depth to top)

4" (size) perforated (material)

(6) pump —, 75-80 (HP) (yield gpm)

AC (type power)

(7) electric log — (yes or no)

(organization running log)

(8) how well bottom plugged orange peel

No. 2 Water Well on location

RECEIVED


MAR 11 1988

Department of Natural Resources
 Bureau of Land & Water Resources

DRILLERS REMARKS:

If well telescopes please sketch and show depths.

GROUND LEVEL

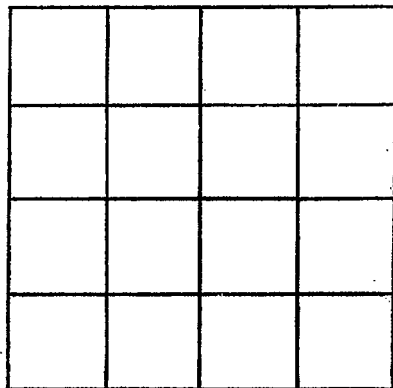

SECTION _____

Please indicate well location X.

ADDITIONAL INFORMATION

If more than one screen, show locations of each on sketch.