

PEARL RIVER
L 2000
12-13-75

MISSISSIPPI
 BOARD OF WATER COMMISSIONERS
 416 North State Street
 Jackson, Mississippi 39201

WATER WELL DRILLERS LOG

12/13 1975 Bud Penton & Son Pearl River
 date/well completed firm name county well located

LANDOWNER: Leonard Jones

description of formations encountered	from	to
	<u>Blue shale</u>	<u>0</u>
<u>Blue Sand Rock</u>	<u>90</u>	<u>185</u>

Poplarville Miss

(mailing address)

WELL LOCATION:

sec 22 3 N R 16 E
^S South ^W West W
2 1/2 miles North of Poplarville
 (distance) (direction) (nearest town)

WELL PURPOSE: home
 (home, irrigation, municipal, industrial)


WELL COMPLETION DATA:

- (1) diameter (inches) 2"
- (2) total depth (feet) 185'
- (3) static water level (feet) 170 below above top of ground.
- (4) casing PVC, 185'
 (material) (depth)
2" if telescope see back.
 (size)
- (5) screen 2x10, 175'
 (length) (depth to top)
12, PVC
 (size) (material)
- (6) pump 1 350 60 gpm.
 (HP) (yield gpm)
- Elect.
 (type power)
- (7) electric log no
 (yes or no)

(organization running log)


(8) how well bottom plugged
Sand Shale

DRILLERS REMARKS:

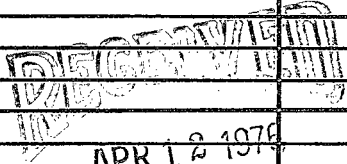

If well telescopes please sketch and show depths.

GROUND LEVEL

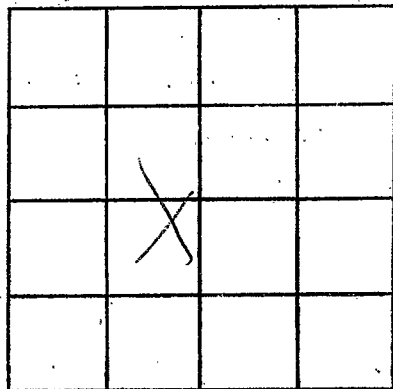

SECTION _____

Please indicate well location X.

ADDITIONAL INFORMATION

If more than one screen,
show locations of each on sketch.