

PEARL RIVER
6 2001
1-12-76

MISSISSIPPI
 BOARD OF WATER COMMISSIONERS
 416 North State Street
 Jackson, Mississippi 39201

WATER WELL DRILLERS LOG


1-12-76 ^{13V} 1926 Lumbkin Well Dr. Pearl River
 date well completed firm name county well located

| LANDOWNER: | description of formations encountered | from | to |
|-------------------------------------------------------------------------------------------|---------------------------------------|------------|------------|
| <u>Sylvan Dubisson</u> <u>Poplarville</u> (mailing address) | | | |
| | <u>Sand</u> | <u>15</u> | <u>120</u> |
| | <u>Clay</u> | <u>120</u> | <u>400</u> |
| | <u>Sand</u> | <u>400</u> | <u>495</u> |
| WELL LOCATION: | | | |
| sec <u>7</u> T <u>3</u> N S R <u>18</u> E W | | | |
| <u>5</u> miles <u>West</u> of <u>Poplarville</u> (distance) (direction) (nearest town) | | | |
| WELL PURPOSE: <u>Home</u> (home, irrigation, municipal, industrial) | | | |
| WELL COMPLETION DATA: | | | |
| (1) diameter (inches) <u>2"</u> | | | |
| (2) total depth (feet) <u>495</u> | | | |
| (3) static water level (feet) <u>40'</u> below top of ground. | | | |
| (4) casing <u>P.V.C. 489'</u> (material) (depth) | | | |
| <u>2"</u> (size) if telescope see back. | | | |
| (5) screen <u>6'</u> <u>489'</u> (length) (depth to top) | | | |
| <u>2"</u> <u>P.V.C.</u> (size) (material) | | | |
| (6) pump <u>1</u> <u>600 G.P.H.</u> (HP) (yield gpm) | | | |
| <u>Elec.</u> <u>109 gpm</u> (type power) | | | |
| (7) electric log <u>No</u> (yes or no) | | | |
| <u>No</u> (organization running log) | | | |
| (8) how well bottom plugged <u>Sand Shale</u> | | | |
| DRILLERS REMARKS: | | | |

RECORDED
 MAR 25 1976

If well telescopes please sketch and show depths.

GROUND LEVEL

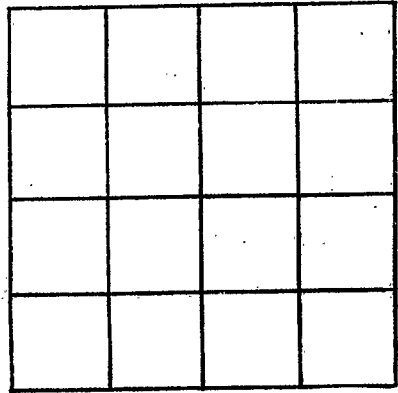

SECTION _____

Please indicate well location X.

ADDITIONAL INFORMATION

If more than one screen,
show locations of each on sketch.