

**PEARL RIVER**  
 L 2002  
 1-27-76

MISSISSIPPI  
 BOARD OF WATER COMMISSIONERS  
 416 North State Street  
 Jackson, Mississippi 39201

WATER WELL DRILLERS LOG


1/27 1976 *Red Penton & Son Pearl River*  
 date well completed firm name county well located

LANDOWNER: <i>Miss 2 M Green</i>	description of formations encountered	from	to
<i>Poplarville miss</i>  (mailing address)	<i>white shale</i> <i>white sand</i> <i>blue shale</i> <i>blue sand</i>	<i>0</i>	<i>75</i>
WELL LOCATION:			
sec. <i>22</i> <i>3</i> N R <i>16</i> E S W <i>3</i> miles <i>south</i> of <i>Poplarville</i> (distance) (direction) (nearest town)			
WELL PURPOSE: <i>home</i> (home, irrigation, municipal, industrial)			
WELL COMPLETION DATA:			
(1) diameter (inches) <i>2 1/2</i>			
(2) total depth (feet) <i>245</i>			
(3) static water level (feet) <i>85</i> below above top of ground.			
(4) casing <i>plc</i> , <i>235</i> , (material) (depth) <i>2 1/2</i> if telescope see back. (size)			
(5) screen <i>2x10</i> , <i>235</i> (length) (depth to top) <i>1/2</i> , <i>plc</i> (size) (material)			
(6) pump <i>1</i> <i>450</i> <i>7gpm</i> (HP) (yield gpm) <i>elect.</i> (type power)			
(7) electric log <i>no</i> (yes or no)			
(organization running log)			
(8) how well bottom plugged <i>Sand Short</i>			
DRILLERS REMARKS:			

RECEIVED  
 APR 12 1976

If well telescopes please sketch and show depths.

GROUND LEVEL

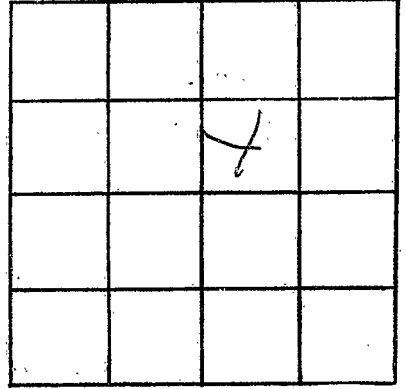

SECTION \_\_\_\_\_

Please indicate well location X.

ADDITIONAL INFORMATION

If more than one screen,  
show locations of each on sketch.