

Pearl River  
L 2004  
3-12-77

MISSISSIPPI  
 BOARD OF WATER COMMISSIONERS  
 416 North State Street  
 Jackson, Mississippi 39201

WATER WELL DRILLERS LOG

3-12 <sup>13V</sup> 1977 Bud Penton Pearl River  
 date well completed firm name county well located

LANDOWNER:	description of formations encountered	from	to
<u>Joney Dandow</u>	<u>Red shale</u>	<u>0</u>	<u>12</u>
<u>Poplarville, Miss</u>	<u>Red sand</u>	<u>12</u>	<u>27</u>
(mailing address)	<u>White shale</u>	<u>27</u>	<u>45</u>
	<u>Brust sand</u>	<u>45</u>	<u>108</u>

WELL LOCATION:  
 sec. 18 T. 3 N. R. 16 E.  
6 miles <sup>SW</sup> of Poplarville  
 (distance) (direction) (nearest town)

WELL PURPOSE: Home  
 (home, irrigation, municipal, industrial)

- WELL COMPLETION DATA:
- (1) diameter (inches) 4 in
  - (2) total depth (feet) 108
  - (3) static water level (feet) 45 below above top of ground.
  - (4) casing PVC 98  
 (material) (depth)  
 (size) if telescope see back.
  - (5) screen 10 98  
 (length) (depth to top)  
4 PVC  
 (size) (material)
  - (6) pump 1/2 650 W  
 (HP) (yield gpm)  
electric  
 (type power)
  - (7) electric log NO  
 (yes or no)

(organization running log)


(8) how well bottom plugged  
sand shale

DRILLERS REMARKS:

**RECEIVED**  
 APR 15 1977

If well telescopes please sketch and show depths.

GROUND LEVEL

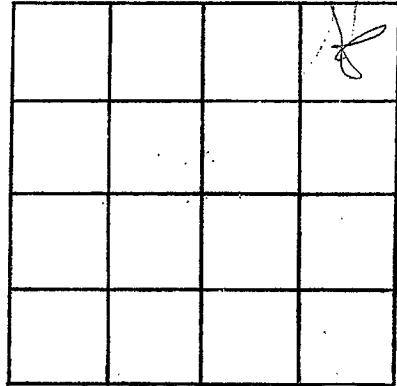

SECTION \_\_\_\_\_

Please indicate well location X.

ADDITIONAL INFORMATION

A series of horizontal lines for recording additional information.

If more than one screen, show locations of each on sketch.