

Pearl River
 L 2005
 6-2-77

MISSISSIPPI
 BOARD OF WATER COMMISSIONERS
 416 North State Street
 Jackson, Mississippi 39201

WATER WELL DRILLERS LOG

6-2-1977 date well completed
 13V Stachtel Bros - firm name
 Pearl River county well located

LANDOWNER:
 Elmer Amacher
 Poplarville, Miss
 (mailing address)

description of formations encountered	from	to
Clay	0	25
Sand	25	80
Clay	80	260
Fine Sand	260	340
Clay	340	380
Sand	380	405

WELL LOCATION:
 sec. 5 T N R E
 6 3 S 16 W
 (distance) (direction) (nearest town)
 6 miles West of Poplarville

WELL PURPOSE: Home
 (home, irrigation, municipal, industrial)


- WELL COMPLETION DATA:
- (1) diameter (inches) 4"
 - (2) total depth (feet) 405
 - (3) static water level (feet) 80' below top of ground.
 - (4) casing P.V.C. 4' (material) (depth)
 4" (size) If telescope see back.
 - (5) screen 10' 29.5' (length) (depth to top)
 4' P.V.C. (size) (material)
 - (6) pump 1 30 (HP) (yield gpm)
 Elec. (type power)
 - (7) electric log No (yes or no)
 No (organization running log)
 - (8) how well bottom plugged Sand Shrub

DRILLERS REMARKS:

RECEIVED
 SEP 22 1977
 MISS. BD. OF WATER COMMISSIONERS

If well telescopes please sketch and show depths.

GROUND LEVEL

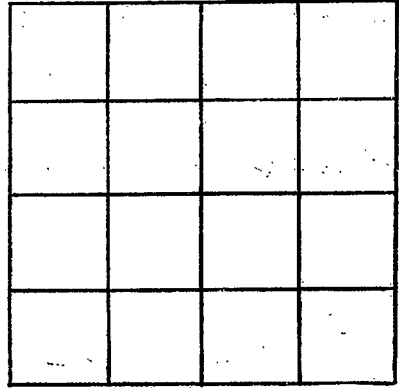

SECTION _____

Please indicate well location X.

ADDITIONAL INFORMATION

If more than one screen, show locations of each on sketch.