

Pearl River
 L 2007
 10/4/77

MISSISSIPPI
 BOARD OF WATER COMMISSIONERS
 416 North State Street
 Jackson, Mississippi 39201

WATER WELL DRILLERS LOG

10-4-77 date well completed
 77 Poncey water firm name
 Pearl River county well located

LANDOWNER: Smith, Derby PFD
MS. 36461
 (mailing address)

description of formations encountered	from	to
clay shale hd.	0	120
slt.	120	130

WELL LOCATION:
 sec. 36 T. 3 N. R. 16 E.
2 miles SE of Derby
 (distance) (direction) (nearest town)

fine to Beth	130	144
--------------	-----	-----

WELL PURPOSE: Home - Camp
 (home, irrigation, municipal, industrial)

- WELL COMPLETION DATA:
- (1) diameter (inches) 2
 - (2) total depth (feet) 144
 - (3) static water level (feet) 60 below top of ground
 - (4) casing PVC, 134 (material), (depth)
 - 2 if telescope see back. (size)
 - (5) screen 10, 134 (length), (depth to top)
 - 2, PVC (size), (material)
 - (6) pump 1 (HP), 9 (yield gpm)
 - AC (type power)
 - (7) electric log (yes or no)
 - (organization running log)
 - (8) how well bottom plugged Sealed.


DRILLERS REMARKS: Good well -

RECEIVED
 MAR 31 1978

MISS. BD. OF WATER COMMISSIONERS

If well telescopes please sketch and show depths.

GROUND LEVEL

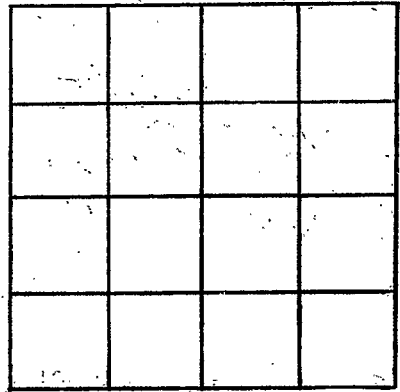

SECTION _____

Please indicate well location X.

ADDITIONAL INFORMATION

If more than one screen, show locations of each on sketch.