

PEARL RIVER

L 2008

5-4-78

MISSISSIPPI BOARD OF WATER COMMISSIONERS
416 North State Street
Jackson, Mississippi 39201

WATER WELL DRILLERS LOG

May 4 1978
date well completed

TOM GRIFFITH Pearl River Co.
PLUMBING & WELL SERVICE, INC.
county well located

LANDOWNER: Davis Rainey
Dorley, Miss.

320 MAYSON AVE.
COLUMBIA, MS 39229
Description of conditions encountered

from to

Top Soil	0	1
Clay	1	10
Black Sand	10	100
Sand	100	130

(mailing address)

WELL LOCATION:

sec. 18 T. 3 N. R. 16 E.
5 miles SW of Poplarville
(distance) (direction) (nearest town)

WELL PURPOSE: Domestic
(home, irrigation, municipal, industrial)

WELL COMPLETION DATA:

- (1) diameter (inches) 2"
- (2) total depth (feet) 130
- (3) static water level (feet) 45 below top of ground.
- (4) casing Plastic 125 (material) (depth)
10 (size) if telescope see back.
- (5) screen 10 120 ((length) (depth to top))
2" Plastic (size) (material)
- (6) pump 1 10 (HP) (yield gpm)
Electric (type power)
- (7) electric log yes (yes or no)
no (organization running log)
- (8) how well bottom plugged B.C.V.


RECEIVED
JUN 30 1978

DRILLERS REMARKS:

MISS. BD. OF WATER COMM

If well telescopes please sketch and show depths.

GROUND LEVEL

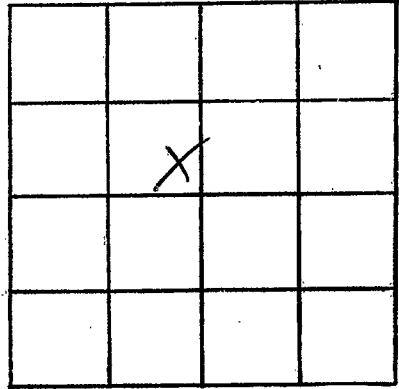

SECTION

14

Please indicate well location X.

ADDITIONAL INFORMATION

If more than one screen,
show locations of each on sketch.