

PEARL RIVER
 L 2010
 9-7-78

MISSISSIPPI
 BOARD OF WATER COMMISSIONERS
 416 North State Street
 Jackson, Mississippi 39201

WATER WELL DRILLERS LOG

Sept. 7 1978 - TOM GRIFFITH
 date well completed name of contractor PLUMBING & WELL SERVICE, INC.
 Pearl River county well located

LANDOWNER:
 Tom Sawyer
 Rt. 2 Box 72
 Deplarville, Miss.
 (mailing address)
 WELL LOCATION:
 sec. 1 T 3 N R 10 E
 2 miles S of Pearl River
 (distance) (direction) (nearest town)

description of formations encountered	from	to
Top soil	0	1
Gravel	1	6
Clay	6	18
Hard sand	18	29
Clay	29	40
Sand	40	110
Clay	110	190
Sand	190	240
Clay	240	262
Clay	262	285

WELL PURPOSE: Home
 (home, irrigation, municipal, industrial)

WELL COMPLETION DATA:
 (1) diameter (inches) 4"
 (2) total depth (feet) 285 ft
 (3) static water level (feet) 180 ft below top of ground.
 (4) casing plastic 275 ft (material) (depth)
 4" (size) if telescope see back.
 (5) screen 10 ft 225 ft (length) (depth to top)
 4" plastic (size) (material)
 (6) pump 1 1/2 HP 12 (HP) (yield gpm)
 Electric (type power)
 (7) electric log No (yes or no)
 (organization running log)
 (8) how well bottom plugged
 Back Wash Valve


RECEIVED
 NOV - 3 1978

MISS. BD. OF WATER COMM

DRILLERS REMARKS:

If well telescopes please sketch and show depths.

GROUND LEVEL

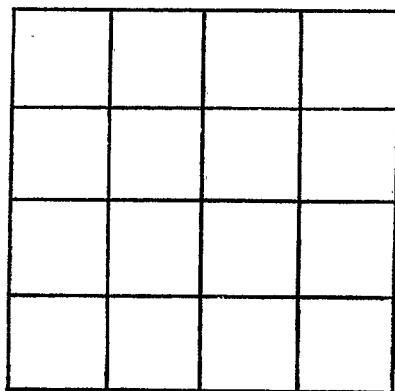

SECTION _____

Please indicate well location X.

ADDITIONAL INFORMATION

If more than one screen,
show locations of each on sketch.