

Pearl River
L 2011
May 21, 1979

MISSISSIPPI
 BOARD OF WATER COMMISSIONERS
 416 North State Street
 Jackson, Mississippi 39201

WATER WELL DRILLERS LOG
 TOM GRIFFITH

PLUMBING & WELL SERVICE, INC.
 320 MAYSON AVE.
 COLUMBIA, MS 39429

Pearl River
 county well located

May 21 19 79
 date well completed

LANDOWNER:
Mr. Harvey Graham
Rt. 4 - Box 113 - Poplarville
 (mailing address) Miss.

description of formations encountered	from	to
<u>Top soil</u>	<u>0</u>	<u>2</u>
<u>Clay</u>	<u>2</u>	<u>19</u>
<u>Clay & sand</u>	<u>19</u>	<u>20</u>
<u>Clay</u>	<u>20</u>	<u>102</u>
<u>Sand</u>	<u>102</u>	<u>128</u>
<u>Hard</u>	<u>128</u>	<u>145</u>

WELL LOCATION:
 sec 15 T 3 N R 16 E
5 miles SW of Poplarville
 (distance) (direction) (nearest town)

WELL PURPOSE: Home
 (home, irrigation, municipal, industrial)

WELL COMPLETION DATA:

- (1) diameter (inches) 2"
- (2) total depth (feet) 145 ft.
- (3) static water level (feet) 60 ft. below top of ground.
- (4) casing plastic, 125 ft.
 (material) (depth)
2" If telescope see back.
 (size)
- (5) screen 20 ft., 125 ft.
 (length) (depth to top)
2" plastic
 (size) (material)
- (6) pump 1 Hp 10 gals.
 (HP) (yield gpm)
Electric
 (type power)
- (7) electric log No
 (yes or no)

(organization running log)

(8) how well bottom plugged
Back wash valve

DRILLERS REMARKS:


Miss. Board of Water Comm.

JUL 9 1979

RECEIVED

If well telescopes please sketch and show depths.

GROUND LEVEL

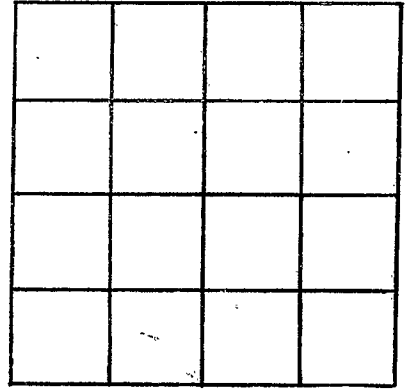

SECTION _____

Please indicate well location X.

ADDITIONAL INFORMATION

If more than one screen, show locations of each on sketch.