

Pearl River

L 2012

5/23/80

MISSISSIPPI
BOARD OF WATER COMMISSIONERS
416 North State Street
Jackson, Mississippi 39201

WATER WELL DRILLERS LOG

1/24 1979 Bud Penton Water Well Pearl River
date well completed firm name county well located

LANDOWNER: Alton Gibson

description of formations encountered

from to

R.T. 4 Box 78 Poplarville
Miss.

Red Shale
White shale
white sand

0 35
35 102
102 128

(mailing address)

WELL LOCATION:

sec. 05 T 3 N R 16 E
2 miles East of Barby
(distance) (direction) (nearest town)

WELL PURPOSE: home
(home, irrigation, municipal, industrial)

WELL COMPLETION DATA:

- (1) diameter (inches) 2"
- (2) total depth (feet) 128
- (3) static water level (feet) 80 below above top of ground.
- (4) casing PVC 128
(material) (depth)
(size) if telescope see back.
- (5) screen 10 118
(length) (depth to top)
12 PVC
(size) (material)
- (6) pump 1 660
(HP) (yield gpm)
Elect.
(type power)
- (7) electric log no
(yes or no)

(organization running log)

(8) how well bottom plugged Shore sand

DRILLERS REMARKS:


DEPT. OF NATURAL RESOURCES
BUREAU OF LAND & WATER RESOURCES

MAY 10 1980

RECEIVED

If well telescopes please
sketch and show depths.

GROUND LEVEL

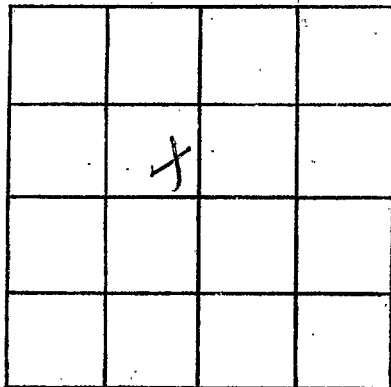

SECTION _____

Please indicate well location X.

ADDITIONAL INFORMATION

If more than one screen,
show locations of each on sketch.