

MISSISSIPPI DEPARTMENT OF NATURAL RESOURCES

Bureau of Land and Water Resources

Southport Mall

P.O. Box 10631

Jackson, Mississippi 39209

WATER WELL DRILLERS LOG

Pearl River
L 2015
10-13-81

Oct 13 1981 Wilhelm Welding, Reps. Pearl River
 date well completed firm name county well located

LANDOWNER:
Velma Cameron
Box 160
Poplarville Miss.
 (mailing address)

description of formations encountered	from	to
<u>white shale</u>	<u>1'</u>	<u>65'</u>
<u>Per gravel</u>	<u>65'</u>	<u>72'</u>
<u>fine white sand</u>	<u>72'</u>	<u>85'</u>
<u>white shale</u>	<u>85'</u>	<u>175'</u>
<u>core white sand</u>	<u>175'</u>	<u>198'</u>

WELL LOCATION:
6
 sec. 8 T. 3 S. R. 1 E. W.
4 miles West of Poplarville
 (distance) (direction) (nearest town)

WELL PURPOSE: None
 (home, irrigation, municipal, industrial)

WELL COMPLETION DATA:

(1) diameter (inches) 2 in.

(2) total depth (feet) 198 ft

(3) static water level (feet) 70 below top of ground.

(4) casing 2" PVC (material), 183' (depth)
 (size) if telescope see back.

(5) screen 10" (length), 183" (depth to top)
12 (size), PVC (material)

(6) pump 1 (HP), 6 gal min (yield gpm)
electric (type power)

(7) electric log (yes or no) _____
 (organization running log) _____

(8) how well bottom plugged Sept
check

DEPT. OF NATURAL RESOURCES
 BUREAU OF LAND & WATER RESOURCES


NOV 10 1981

RECEIVED

DRILLERS REMARKS: _____

If well telescopes please sketch and show depths.

GROUND LEVEL

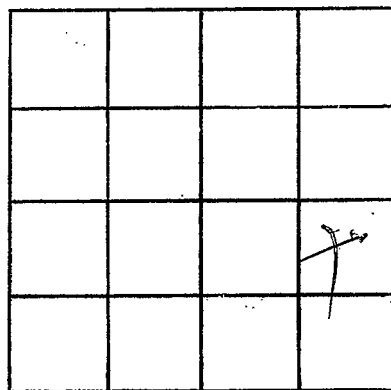

SECTION _____

Please indicate well location X.

ADDITIONAL INFORMATION

If more than one screen,
show locations of each on sketch.