

MISSISSIPPI DEPARTMENT OF NATURAL RESOURCES

Bureau of Land and Water Resources

Southport Mall

P.O. Box 10631

Jackson, Mississippi 39209

WATER WELL DRILLERS LOG

Real River
2016 L

1982 SOURCE WATER WELL DRILLING

Real River

4-9- date well completed

firm name

county well located

LANDOWNER: Dennis Browne

description of formations encountered

from

to

Derby St.

Top - Clay -
80.

0 80
80 105

(mailing address)

WELL LOCATION:

sec 28 T 3 N R 16 E
1 miles SW of Derby
(distance) (direction) (nearest town)

WELL PURPOSE: Tractor
(home, irrigation, municipal, industrial)

WELL COMPLETION DATA:

- (1) diameter (inches) 2
- (2) total depth (feet) 105
- (3) static water level (feet) 76 below above top of ground.
- (4) casing PVC 100
(material) (depth)
2 if telescope see back.
(size)
- (5) screen 5 100
(length) (depth to top)
2 PVC
(size) (material)
- (6) pump 1 6
(HP) (yield gpm)
220V AC
(type power)
- (7) electric log /
(yes or no)
/
(organization running log)
- (8) how well bottom plugged Sealed

DEPT. OF NATURAL RESOURCES
BUREAU OF LAND & WATER RESOURCES


JUN - 1 1982

RECEIVED

DRILLERS REMARKS:

If well telescopes please
sketch and show depths.

GROUND LEVEL

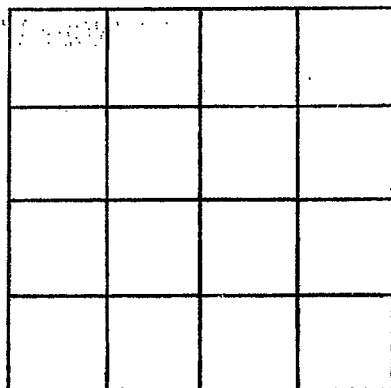

SECTION _____

Please indicate well location X.

ADDITIONAL INFORMATION

If more than one screen,
show locations of each on sketch.