

MISSISSIPPI DEPARTMENT OF NATURAL RESOURCES

Bureau of Land and Water Resources

Southport Mall

P.O. Box 10631

Jackson, Mississippi 39209

BUD PENTON & SON
WATER WELL SERVICE
ROUTE 4 BOX 402
CARRIERS, MS 39202
PHONE 788-8824

WATER WELL DRILLERS LOG

Pearl River
L 2017

97

19 83

11/11
date well completed

BUD PENTON & SON
WATER WELL SERVICE
ROUTE 4 BOX 402
CARRIERS, MS 39202
PHONE 788-8824

Pearl River
county well located

LANDOWNER: J.M. Howard

PO Box 452 Poplarville Miss

(mailing address)

description of formations encountered

from to

Red shale
Blue shale
Gray sand

0 20
20 369
340 369

WELL LOCATION:

sec. 23 T. 3 N. R. 16 E.
S. W.
17 miles S of Poplarville
(distance) (direction) (nearest town)

WELL PURPOSE: home
(home, irrigation, municipal, industrial)

WELL COMPLETION DATA:

- (1) diameter (inches) 4"
- (2) total depth (feet) 369
- (3) static water level (feet) 147 below above top of ground.
- (4) casing PVC 369
(material) (depth)
(size) if telescope see back.
- (5) screen 15 1/2 354
(length) (depth to top)
10 PVC
(size) (material)
- (6) pump 70
(HP) (yield gpm)
(type power)
- (7) electric log no
(yes or no)
no
(organization running log)
- (8) how well bottom plugged: hard
short

DEPT. OF NATURAL RESOURCES
BUREAU OF LAND & WATER RESOURCES


MAR 23 1984

RECEIVED

DRILLERS REMARKS: no pump
furnished

If well telescopes please sketch and show depths.

GROUND LEVEL

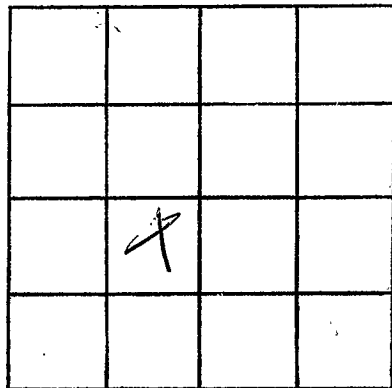

SECTION _____

Please indicate well location X.

ADDITIONAL INFORMATION

If more than one screen, show locations of each on sketch.