

L 2018
 PEARL RIVER
 3-2-85

MISSISSIPPI
 BOARD OF WATER COMMISSIONERS
 416 North State Street
 Jackson, Mississippi 39201

RECEIVED

APR 15 1985

WATER WELL DRILLERS LOG

3/2/85
 date well completed

Staffed Well Service
 firm name

Department of Natural Resources
 Bureau of Land & Water

LANDOWNER <i>Edward Withemast</i> <i>Poplarville, Miss</i> (mailing address)	description of formations encountered	depth	
		from	to
	<i>top soil</i>	<i>0</i>	<i>1</i>
	<i>red clay</i>	<i>1</i>	<i>30</i>
	<i>sandy clay</i>	<i>30</i>	<i>70</i>
	<i>sand & fine gravel</i>	<i>70</i>	<i>100</i>

WELL LOCATION:
 sec. 2 T. 3 N R. 16 E
5 miles West of Poplarville
 (distance) (direction) (nearest town)

WELL PURPOSE: Home
 (home, irrigation, municipal, industrial)

WELL COMPLETION DATA:

(1) diameter (inches) 4"

(2) total depth (feet) 100'

(3) static water level (feet) 70 below above top of ground.


(4) casing Plastic, 90
 (material) (depth)
4" If telescope see back.
 (size)

(5) screen 10', 90'
 (length) (depth to top)
4", Plastic
 (size) (material)

(6) pump 1/2, 12 gpm
 (HP) (yield gpm)
elect.
 (type power)


(7) electric log (yes or no) _____
 (organization running log) _____

(8) how well bottom plugged DWU

DRILLERS REMARKS:


If well telescopes please sketch and show depths.

GROUND LEVEL

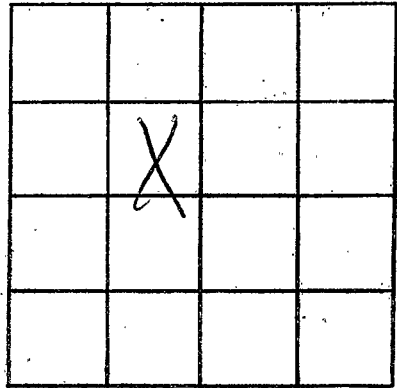

SECTION 2

Please indicate well location X.

ADDITIONAL INFORMATION

If more than one screen,
show locations of each on sketch.