

MISSISSIPPI DEPARTMENT OF NATURAL RESOURCES

Bureau of Land and Water Resources

Southport Mall

P.O. Box 10631

Jackson, Mississippi 39209

WATER WELL DRILLERS LOG

PEARL RIVER
L 2019

7-26-85

POUNCEY WATER WELL DRILLING Paul Rivers

date well completed

firm name

county well located

LANDOWNER:

Stone Jones
Darby

description of formations encountered

from

to

Top Claystone	0	46
Blk	46	108
good sd.	108	130
fine tight sd.	130	158
good brown sd.	158	173

(mailing address)

WELL LOCATION:

sec. 33 T 3 N R 16 E
1 miles S of Darby

WELL PURPOSE:

(home, irrigation, municipal, industrial)

WELL COMPLETION DATA:

- (1) diameter (inches) 4
- (2) total depth (feet) 173
- (3) static water level (feet) 80 below above top of ground.
- (4) casing PVC 163 (material) (depth) (size) if telescope see back.
- (5) screen 10 163 (length) (depth to top) (size) (material)
- (6) pump 1 18 (HP) (yield gpm) (type power)
- (7) electric log (yes or no)
- (organization running log)
- (8) how well bottom plugged Sealed

RECEIVED


NOV 15 1985

Department of Natural Resources
Bureau of Land & Water Resources

DRILLERS REMARKS:

If well telescopes please sketch and show depths.

GROUND LEVEL

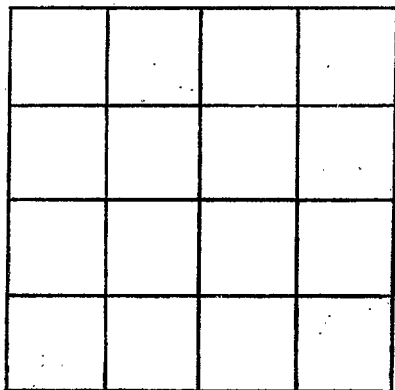

SECTION _____

Please indicate well location X.

ADDITIONAL INFORMATION

If more than one screen,
show locations of each on sketch.