

MISSISSIPPI DEPARTMENT OF NATURAL RESOURCES

Bureau of Land and Water Resources

Southport Mall

P.O. Box 10631

Jackson, Mississippi 39209

WATER WELL DRILLERS LOG

P. RIVER  
L 2022

6/11 1990 Bud Benton Pearl River  
date well completed firm name county well located

LANDOWNER: <u>William Satt</u>	description of formations encountered	from	to
<u>Dist 26 Poplarville Miss</u> (mailing address)		<u>Red shale</u> <u>white sand</u>	<u>0</u>

WELL LOCATION:  
sec 4 T 3 N R 16 E  
S W  
4 miles W Poplarville  
(distance) (direction) (nearest town)

WELL PURPOSE: home  
(home, irrigation, municipal, industrial)

- WELL COMPLETION DATA:
- (1) diameter (inches) 4 1/2
  - (2) total depth (feet) 164
  - (3) static water level (feet) 30 below top of ground.
  - (4) casing pvc, 64,  
(material) (depth)  
(size) if telescope see back.
  - (5) screen 10, 54  
(length) (depth to top)  
10, pvc  
(size) (material)
  - (6) pump 1/2, 1/2  
(HP) (yield gpm)  
Elect  
(type power)
  - (7) electric log no  
(yes or no)

(organization running log)  
(8) how well bottom plugged hard  
start


DRILLERS REMARKS:

RECEIVED  
OCT 15 1990

Department of Natural Resources  
Bureau of Land & Water Resources

If well telescopes please  
sketch and show depths.

GROUND LEVEL

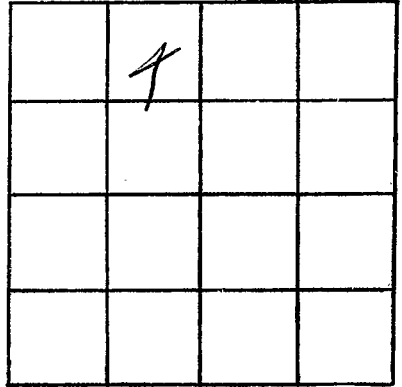

SECTION \_\_\_\_\_

Please indicate well location X.

ADDITIONAL INFORMATION

If more than one screen,  
show locations of each on sketch.