

MISSISSIPPI DEPARTMENT OF ENVIRONMENTAL QUALITY

Office of Land and Water Resources

P. O. Box 10631
Jackson, MS 39289-0631
WATER WELL DRILLERS LOG

COUNTY WELL LOCATED <u>Pearl River</u>	
WELL NUMBER <u>L-2030</u>	CODED
DATE WELL COMPLETED <u>9-3-99</u>	

PERMIT NUMBER
NAME OF DRILLING FIRM <u>Boones Waterwell</u>

NAME & MAILING ADDRESS OF LANDOWNER <u>James Bryant</u> <u>89 Buford Lane</u> <u>Poplarville, MS 39470</u>			
WELL LOCATION:	SEC <u>27</u>	TOWNSHIP <u>3 N</u>	RANGE <u>16 E</u>
DISTANCE <u>6</u> Miles	DIRECTION <u>South</u>	NEAREST TOWN <u>Poplarville</u>	
OTHER LANDMARK			
WELL PURPOSE: <input checked="" type="checkbox"/> Home Irrigation, <input type="checkbox"/> Municipal, <input type="checkbox"/> Industrial, <input type="checkbox"/> Fish Pond, etc.			

PUMP DATA			
PUMP TYPE (Circle One): <input checked="" type="checkbox"/> Submersible, <input type="checkbox"/> Turbine, <input type="checkbox"/> Jet, <input type="checkbox"/> Flowing Well, Other (Describe) _____			
POWER TYPE (Circle One): <input checked="" type="checkbox"/> Electric, <input type="checkbox"/> Tractor, <input type="checkbox"/> Diesel, <input type="checkbox"/> Gasoline, <input type="checkbox"/> Butane, Other (Describe) _____ H/P <u>1</u>			
Pump Capacity (GPM) <u>20</u>	No. of Stages	Setting Depth _____ FT.	
PUMP TEST Well yielded _____ GPM with a drawdown of _____ ft. after _____ hours of pumping			

WELL DATA		
Well Depth <u>140</u>	Casing Diameter (In.) <u>4in</u>	Casing Length (Ft.) <u>120</u>
Type of Casing <u>SCH 40</u>	Hole Depth <u>140</u>	Depth to Static Water Level <u>70</u>

LOG DATA	
TYPE OF LOG RUN (Circle One): <input type="checkbox"/> No Log Run, <input type="checkbox"/> Electric, <input type="checkbox"/> Gamma Ray, <input type="checkbox"/> Density, <input type="checkbox"/> Sonic, <input type="checkbox"/> Neutron, Other (Describe) _____	
Name of Organization Running Log	

TYPE OF COMPLETION: (Circle One or More):
 Gravel Packed, Underreamed, Telescoped,
 Natural Development, Open Hole, Other

GEOLOGIC DATA (Office Use Only)			
Surface Elev.	Geologic Unit	Unit Thickness	Depth to Top
Subs. SWL	Date	Analysis	Aquifer Test

WELL GROUTED TO A DEPTH OF 10 FEET
Type Grout (circle one): Cement, Bentonite, or Mix

Driller's Remarks	
Top of Lap Pipe or Reduction in Casing	
FEET	IF TELESCOPED OR MORE THAN ONE SCREEN: USE BACK PAGE

SCREEN DATA		
Diameter - Inches <u>4in</u>	Length - Feet <u>20</u>	Slot Size - Inches <u>#8</u>
Screen Type <u>SCH 40</u>	Depth to Bottom - Feet	

DESCRIPTION OF FORMATIONS ENCOUNTERED	FROM	TO	FORMATIONS (Continued)	FROM	TO
<u>Sand</u>	<u>0</u>	<u>30</u>			
<u>Clay</u>	<u>30</u>	<u>90</u>			
<u>Sand</u>	<u>90</u>	<u>140</u>			


DISCEMBER 15
JUL 27 2000

Dept. of Environmental Quality
Office of Land & Water Resources

IF MORE SPACE IS NEEDED, USE BACK

If well telescopes please
sketch and show depths.

GROUND LEVEL

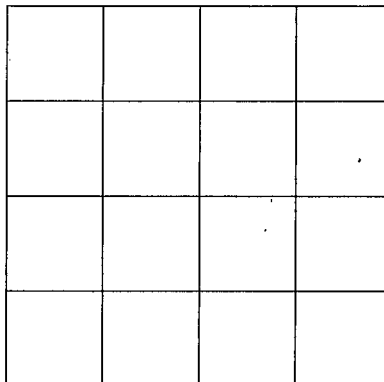

SECTION _____

Please indicate well location X.

ADDITIONAL INFORMATION

If more than one screen,
show location of each on sketch.