

PEARL RIVER
M-9
7-2-71

MISSISSIPPI
 BOARD OF WATER COMMISSIONERS
 416 North State Street
 Jackson, Mississippi 39201

CODED

WATER WELL DRILLERS LOG

7-2- 1971 HORACE A. POOLE PEARL RIVER
 date well completed firm name county well located

LANDOWNER: <u>P.A. Tims Jr</u> <u>RT#3</u>	description of formations encountered	from	to
<u>Poplarville Miss</u> (mailing address)	<u>Sandy clay</u>	<u>0</u>	<u>10</u>
	<u>Clay</u>	<u>10</u>	<u>60</u>
	<u>fine sand</u>	<u>60</u>	<u>70</u>
	<u>Clay</u>	<u>70</u>	<u>180</u>
	<u>Silt</u>	<u>180</u>	<u>230</u>
	<u>SAND</u>	<u>230</u>	<u>248</u>
	<u>UNKNOWN</u>	<u>248</u>	<u>255</u>
WELL LOCATION: sec. <u>17</u> T. <u>3</u> N. R. <u>15</u> E. S. W.			
<u>5</u> miles <u>SE</u> of <u>Poplarville</u> (distance) (direction) (nearest town)			
WELL PURPOSE: <u>POTW</u> (home, irrigation, municipal, industrial)			
WELL COMPLETION DATA:			
(1) diameter (inches) <u>2"</u>			
(2) total depth (feet) <u>255</u>			
(3) static water level (feet) <u>133</u> below top of ground.			
(4) casing <u>Galv</u> <u>252'</u> (material) (depth)			
<u>2</u> if telescope see back. (size)			
(5) screen <u>3'</u> <u>252</u> (length) (depth to top)			
<u>.008</u> <u>STAINLESS STEEL</u> (size) (material)			
(6) pump _____ (HP) _____ (yield gpm)			
(type power)			
(7) electric log _____ (yes or no)			
(organization running log)			
(8) how well bottom plugged _____			
DRILLERS REMARKS: <u>at 248'</u> <u>Bell Through with</u> <u>no Returns at</u> <u>Surface</u>			


CODED

AUG 2 1971

MISSISSIPPI
 BOARD OF WATER COMMISSIONERS
 JACKSON, MISSISSIPPI

If well telescopes please sketch and show depths.

GROUND LEVEL

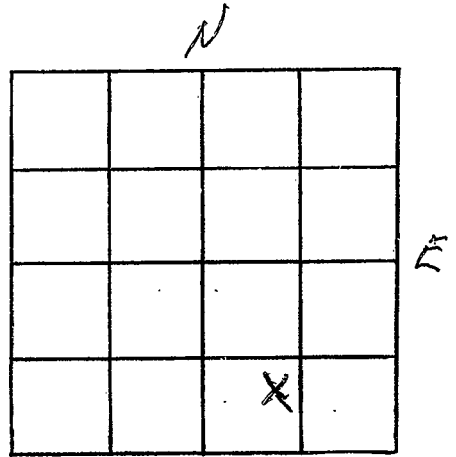

SECTION 17

Please indicate well location X.

ADDITIONAL INFORMATION

If more than one screen,
show locations of each on sketch.