

Pearl R.
M-11
3-18-61

MISSISSIPPI BOARD OF WATER COMMISSIONERS

WATER WELL DRILLERS LOG

CODED

Date: May 8, 1961, Driller: Leo Laker County: Paul Jones
(Name)

(1) Owner of Land: Otis Smith
(Name)
Poplarville Miss
(Address)

Description & Color of Materials Sand, Clay, Red Clay, Shell, etc.	Thick- ness Feet	Depth Feet
<u>Red clay</u>	<u>40</u>	<u>0-40</u>
<u>Sandy clay</u>	<u>5</u>	<u>40-45</u>
<u>Sand & gravel</u>	<u>20</u>	<u>45-65</u>

(2) Location: 1/4, 1/4, Sec. 34 T. 3R15,
1.5 miles South of Poplarville
(distance) (direction) (Nearest Town)

(3) Topography: (Hilly) (Flat) (Level)


(4) Purpose of Well: Home Use
(Domestic Irrigation, Municipal, Industrial, Other)

Information upon completion of well:

- (1) Diameter: 4" inches.
- (2) Total Depth: 65 feet.
- (3) Water Level: 45" feet below top of ground.
- (4) Cased to: 65, Size: 4"
- (5) Screen: Size: 1/8", Length: 6"
- (6) Were any formations sealed against pollution?
_____ yes, no.

If YES depth of formation _____
Why: _____
Drillers Remarks: _____

CODED

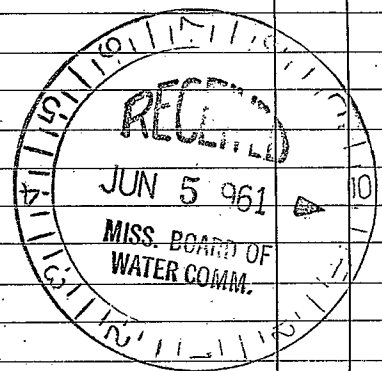

Well No.

(Use Back Side)

