

PEARL RIVER
M14
12-29-71

MISSISSIPPI
 BOARD OF WATER COMMISSIONERS
 416 North State Street
 Jackson, Mississippi 39201

CODED

NOV 9 1971

WATER WELL DRILLERS LOG


12-29-1971 *Need Lumphin Well Pearl River*
 date well completed firm name county well located
Drilling Service

LANDOWNER	description of formations encountered	from	to
<i>Russell A. Casey</i>			
<i>Paplarville Miss. 6260 Louisville St. New Orleans, La. 70124</i> (mailing address)	<i>Surface Clay</i>	<i>0</i>	<i>10</i>
	<i>sand</i>	<i>10</i>	<i>40</i>
WELL LOCATION: <i>9</i> sec. <i>2</i> <i>3</i> T. <i>3</i> <i>5</i> S. R. <i>15</i> <i>15</i> W.	<i>whitesto blue clay</i>	<i>40</i>	<i>200</i>
<i>2</i> miles <i>East</i> of <i>Paplarville</i> (distance) (direction) (nearest town)	<i>good sand</i>	<i>200</i>	<i>237</i>
WELL PURPOSE: <i>home</i> (home, irrigation, municipal, industrial)			
WELL COMPLETION DATA:			
(1) diameter (inches) <i>2"</i>			
(2) total depth (feet) <i>237</i>			
(3) static water level (feet) <i>143</i> below top of ground.			
(4) casing <i>galv.</i> (material) (depth)			
<i>2"</i> (size) if telescope see back.			
(5) screen <i>5'</i> (length) (depth to top)			
<i>2"</i> (size) <i>St. Steel</i> (material)			
(6) pump <i>1 1/2</i> <i>300</i> <i>phr</i> (HP) (yield gpm)			
<i>electric</i> (type power)			
(7) electric log <i>no</i> (yes or no)			
(organization running log)			
(8) how well bottom plugged <i>Johnson</i> <i>BP Valve</i>			
DRILLERS REMARKS:			

CODED

If well telescopes please sketch and show depths.

GROUND LEVEL

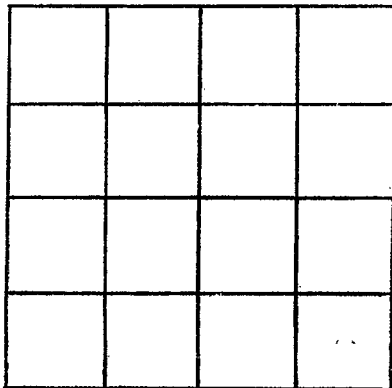

SECTION _____

Please indicate well location X.

ADDITIONAL INFORMATION

If more than one screen,
show locations of each on sketch.