

PEARL River
M 15
11-26-71

MISSISSIPPI
BOARD OF WATER COMMISSIONERS
416 North State Street
Jackson, Mississippi 39201

WATER WELL DRILLERS LOG

11-26 date well completed 1971 East Pearl River water well serv. Pearl River firm name county well located

LANDOWNER:
Brendal Ford Farms
Poplarville MISS.
(mailing address)

WELL LOCATION:
sec. 3 T. 3 N. R. 15 E.
2 miles East of Poplarville
(distance) (direction) (nearest town)

WELL PURPOSE: Industrial
(home, irrigation, municipal, industrial)

- WELL COMPLETION DATA:
- (1) diameter (inches) 7 1/2"
 - (2) total depth (feet) 260'
 - (3) static water level (feet) 152' below top of ground.
 - (4) casing Plastic, 240' (material) (depth)
 - 4 (size) If telescope see back.
 - (5) screen 20, 240 (length) (depth to top)
 - 4" Plastic (size) (material)
 - (6) pump 2 (HP) 158 G.P.M. (yield gpm)
 - Elect (type power)
 - (7) electric log NO (yes or no)
 - (organization running log)
 - (8) how well bottom plugged shoe

description of formations encountered	from	to
Red clay	0	3
Red clay & sand	3	32
Red clay	32	60
to white clay	60	165
Blue clay	165	200
Red med sd.	200	224
course Red sd.	224	260


MAR 29 1972

DRILLERS REMARKS:

8

If well telescopes please sketch and show depths.

GROUND LEVEL

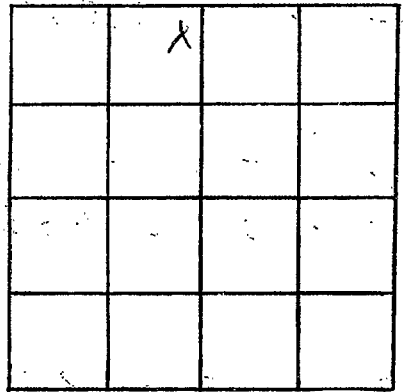

SECTION 3

Please indicate well location X.

ADDITIONAL INFORMATION

If more than one screen, show locations of each on sketch.