

PEARL RIVER
M 16
2-24-72

MISSISSIPPI
 BOARD OF WATER COMMISSIONERS
 416 North State Street
 Jackson, Mississippi 39201

CODED

MAR 22 1972

WATER WELL DRILLERS LOG

2-24 1972 Hanna & A Poole Pearl River
 date well completed firm name county well located

LANDOWNER: <u>Dembrey Seal</u>	description of formations encountered	from	to
<u>POPLARVILLE MISS</u>			
(mailing address)	<u>CLAY</u>	<u>0</u>	<u>10</u>
	<u>SANDY CLAY</u>	<u>10</u>	<u>18</u>
	<u>SANDY</u>	<u>18</u>	<u>36</u>

WELL LOCATION:
 sec. 5 T. 3 N. R. 15 E.
 S W
3 miles E of Poplarville
 (distance) (direction) (nearest town)

WELL PURPOSE: Home
 (home, irrigation, municipal, industrial)


- WELL COMPLETION DATA:
- (1) diameter (inches) 4
 - (2) total depth (feet) 36
 - (3) static water level (feet) 20 below top of ground.
 - (4) casing PVC, 31
 (material) (depth)
2"
 (size) if telescope see back.
 - (5) screen 5', 31
 (length) (depth to top)
010, PVC
 (size) (material)
 - (6) pump 3/4 10
 (HP) (yield gpm)
Electric
 (type power)
 - (7) electric log NO
 (yes or no)
- (organization running log)
- (8) how well bottom plugged BACK
WBS & WPL

CODED

DRILLERS REMARKS:

If well telescopes please sketch and show depths.

GROUND LEVEL

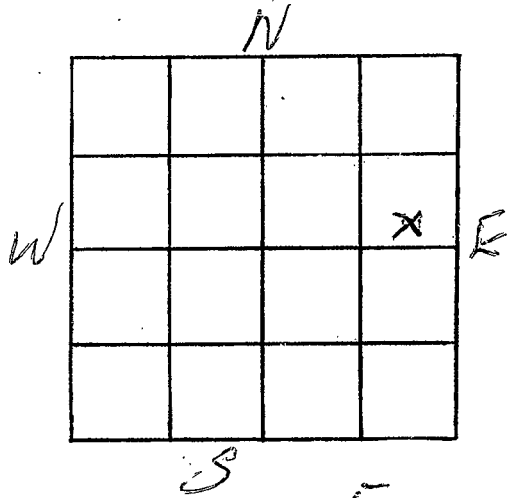

SECTION 5

Please indicate well location X.

ADDITIONAL INFORMATION

If more than one screen, show locations of each on sketch.