

PEARL RIVER
M 18
2-22-72

MISSISSIPPI BOARD OF WATER COMMISSIONERS
416 North State Street
Jackson, Mississippi 39201

CODED

MAR 22 1972

WATER WELL DRILLERS LOG

2-22-1972 date well completed
Horace A. Poole firm name
Pearl River county well located

LANDOWNER: O.C. Smith
Pellairville MISS
RT# 3
(mailing address)

description of formations encountered	from	to
	<u>Sandy clay</u>	<u>0</u>
<u>SAND</u>	<u>20</u>	<u>85</u>

WELL LOCATION:
sec. 29 T 3 N R. 15 W
S W
7 miles S.E. of Pville
(distance) (direction) (nearest town)

WELL PURPOSE: Home
(home, irrigation, municipal, industrial)


- WELL COMPLETION DATA:
- (1) diameter (inches) 7"
 - (2) total depth (feet) 85'
 - (3) static water level (feet) 50 below top of ground.
 - (4) casing Pvc 75'
(material) (depth)
4" if telescope see back.
(size)
 - (5) screen 10' 75'
(length) (depth to top)
010 Pvc
(size) (material)
 - (6) pump 1 24
(HP) (yield gpm)
Clec
(type power)
 - (7) electric log no
(yes or no)
- (organization running log)
- (8) how well bottom plugged Back
with valve

DRILLERS REMARKS:

CODED

If well telescopes please sketch and show depths.

GROUND LEVEL

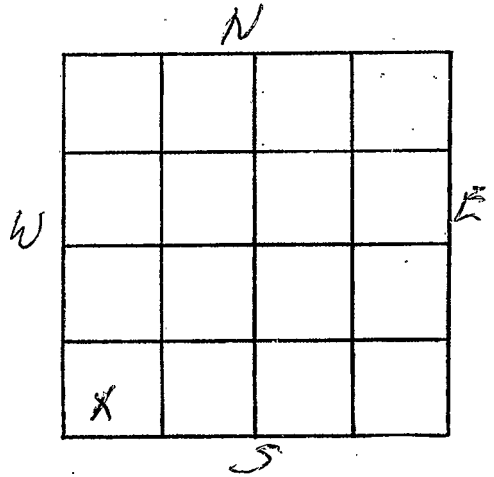

SECTION 29

Please indicate well location X.

ADDITIONAL INFORMATION

If more than one screen,
show locations of each on sketch.