

Pearl River
M19
6-27-72

MISSISSIPPI
 BOARD OF WATER COMMISSIONERS
 416 North State Street
 Jackson, Mississippi 39201

CODED

WATER WELL DRILLERS LOG

6-27-72 date well completed Earl Penton water well serv. Pearl River firm name county well located

LANDOWNER:
Donaldritchard
Poplarville miss.
 (mailing address)

description of formations encountered	from	to
<u>Red clay</u>	<u>0</u>	<u>14</u>
<u>Fine red sd.</u>	<u>14</u>	<u>25</u>
<u>Co. white sd. & gr.</u>	<u>25</u>	<u>52</u>

WELL LOCATION:
 sec 3 T 3 N R 15 E
3 miles 5 East of Poplarville
 (distance) (direction) (nearest town)

WELL PURPOSE: Home
 (home, irrigation, municipal, industrial)

- WELL COMPLETION DATA:
- (1) diameter (inches) 4.5
 - (2) total depth (feet) 52
 - (3) static water level (feet) 36 below top of ground
 - (4) casing Pipe (material), 47' (depth)
2" (size) if telescope see back.
 - (5) screen 5' (length), 47' (depth to top)
2" (size), Pipe (material)
 - (6) pump 1 (HP), 500 (yield gpm)
Elect (type power)
 - (7) electric log NO (yes or no)
 - (organization running log)
 - (8) how well bottom plugged Shoe

CODED


Jul 21 1972

MISS. SD. OF
 WATER RESOURCES

DRILLERS REMARKS:

If well telescopes please sketch and show depths.

GROUND LEVEL

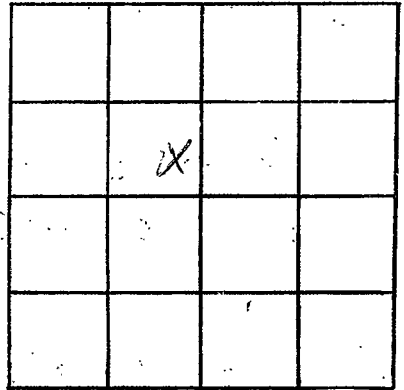

SECTION 3

Please indicate well location X.

ADDITIONAL INFORMATION

If more than one screen, show locations of each on sketch.