

CODED

MISSISSIPPI
BOARD OF WATER COMMISSIONERS
416 North State Street
Jackson, Mississippi 39201

WATER WELL DRILLERS LOG

Pearl River
M 21
6-69

6-12 1969 Horace A Poole Pearl River
date well completed firm name county well located

LANDOWNER: H. L. SMITH

RT # 3

POPLARVILLE MISS
(mailing address)

WELL LOCATION:

sec. 29 T. 3 R. 15 E
5 miles SE of POPLARVILLE
(distance) (direction) (nearest town)

WELL PURPOSE: HOME
(home, irrigation, municipal, industrial)

WELL COMPLETION DATA:

- (1) diameter (inches) 4
- (2) total depth (feet) 63
- (3) static water level (feet) 30 below above top of ground.
- (4) casing PVC 58
(material) (depth)
2" if telescope see back.
(size)
- (5) screen 5" 58
(length) (depth to top)
2" PVC
(size) (material)
- (6) pump 3/4 4
(HP) (yield gpm)
Elec
(type power)
- (7) electric log NA
(yes or no)

(organization running log)

(8) how well bottom plugged

description of formations encountered

from to

SANDY CLAY	0	30
SAND & GRAVEL	30	63


JUL 1 1969

MISS. Bd. of WATER COMMISSIONERS

DRILLERS REMARKS:

If well telescopes please sketch and show depths.

GROUND LEVEL

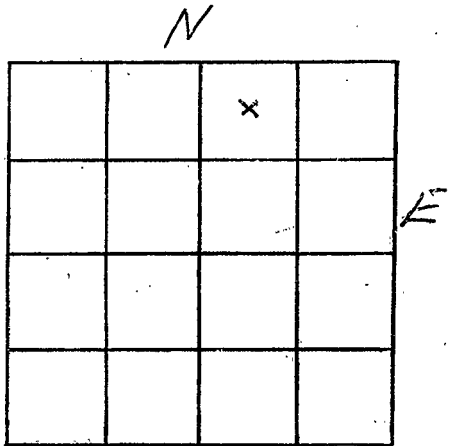

5 SECTION 29

Please indicate well location X.

ADDITIONAL INFORMATION

If more than one screen,
show locations of each on sketch.