

PEARL RIVER  
M 25  
8-26-72

MISSISSIPPI  
BOARD OF WATER COMMISSIONERS  
416 North State Street  
Jackson, Mississippi 39201

WATER WELL DRILLERS LOG **CODED**

8-26 1972 Howe & Poole Pearl River  
date well completed firm name county well located

LANDOWNER: John W. Lilly  
RT 2 Poplarville, Miss  
(mailing address)

description of formations encountered	from	to
<u>Sandy clay</u>	<u>0</u>	<u>10</u>
<u>Gravel</u>	<u>10</u>	<u>20</u>
<u>SAND &amp; Gravel</u>	<u>20</u>	<u>53</u>

WELL LOCATION:  
sec. 9-T-3 N<sup>S</sup> R. 15 E<sup>W</sup>  
9 miles SE of Poplarville  
(distance) (direction) (nearest town)

WELL PURPOSE: Home  
(home, irrigation, municipal, industrial)

- WELL COMPLETION DATA:
- (1) diameter (inches) 4 1/2
  - (2) total depth (feet) 53
  - (3) static water level (feet) 27 below above top of ground.
  - (4) casing Pvc 48'  
(material) (depth)  
2"  
(size) if telescope see back.
  - (5) screen 5 48'  
(length) (depth to top)  
2" 0.10 Pvc  
(size) (material)
  - (6) pump 1 4  
(HP) (yield gpm)  
Elec  
(type power)
  - (7) electric log no  
(yes or no)


<b>CODED</b>		
SEP 25 1972		
L.B.S.S. BD. U WATER COM.		

(organization running log)  
(8) how well bottom plugged  
B.W. Howe

DRILLERS REMARKS:

If well telescopes please sketch and show depths.

GROUND LEVEL

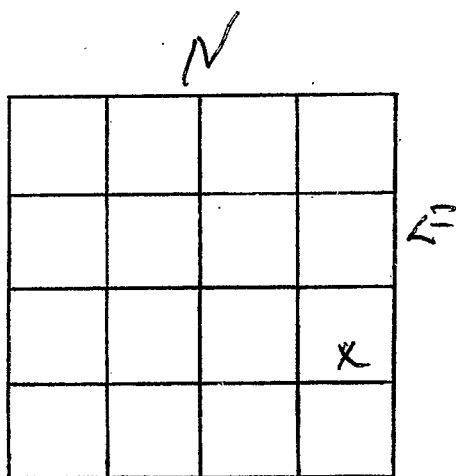

SECTION 9

Please indicate well location X.

ADDITIONAL INFORMATION

If more than one screen, show locations of each on sketch.