

PEARL RIVER
M 26
8-16-72

MISSISSIPPI
BOARD OF WATER COMMISSIONERS
416 North State Street
Jackson, Mississippi 39201

CODED

WATER WELL DRILLERS LOG

8-16

1972 Earl Penston Water Well Serv. Pearl River

date well completed

firm name

county well located

LANDOWNER:

B. L. Rogers

description of formations encountered

coarse red sd.

from

to

0 32

Poplarville miss.
(mailing address)

white clay

32 140

WELL LOCATION:

sec 3 T 3 N R 15 E
3 miles East of Poplarville
(distance) (direction) (nearest town)

Blue clay sd.

140 170

WELL PURPOSE: Home
(home, irrigation, municipal, industrial)

WELL COMPLETION DATA:

- (1) diameter (inches) 8
- (2) total depth (feet) 170
- (3) static water level (feet) 140 below above top of ground.
- (4) casing Plastic, 170 (material) (depth)
- 4 (size) if telescope see back.
- (5) screen 10 160 (length) (depth to top)
- 4 Plastic (size) (material)
- (6) pump 1 730 (HP) (yield gpm)
- Elect. (type power)
- (7) electric log NO (yes or no)

CODED

(organization running log)

(8) how well bottom plugged Skoe


NOV 27 1972

DRILLERS REMARKS:

MISSISSIPPI
WATER COMMISSIONERS

If well telescopes please sketch and show depths.

GROUND LEVEL

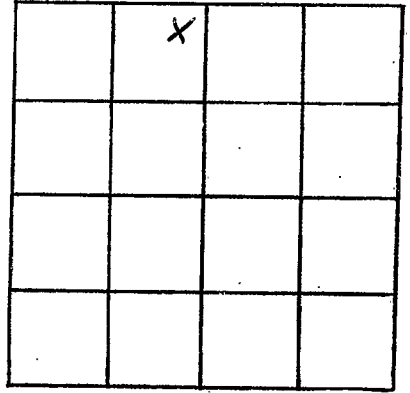

SECTION 3

Please indicate well location X.

ADDITIONAL INFORMATION

If more than one screen,
show locations of each on sketch.