

P. R.
M 29
4-1-74

MISSISSIPPI
BOARD OF WATER COMMISSIONERS
416 North State Street
Jackson, Mississippi 39201

CODED

WATER WELL DRILLERS LOG
GRINER - GINN

Pearl River

4-1 1974 date well completed firm name Pearl River county well located

LANDOWNER:
Mr. H. G. Williamson
Rt. 2, Box 38 Poplarville
(mailing address) Miss.

description of formations encountered	from	to
Top Soil	0	1
clay	1	48
Clay & gravel	48	175
clay	175	207
Sand	207	26

WELL LOCATION:
sec. 9 T 34 R 15 E (W)
5 miles SE of Poplarville
(distance) (direction) (nearest town)

WELL PURPOSE: Home
(home, irrigation, municipal, industrial)

- WELL COMPLETION DATA:
- (1) diameter (inches) 4"
 - (2) total depth (feet) 260
 - (3) static water level (feet) 110 below top of ground.
 - (4) casing plastic, 150 (material) (depth)
4" (size) if telescope see back.
 - (5) screen 10' 250 (length) (depth to top)
4" plastic (size) (material)
 - (6) pump 3/4 9 (HP) (yield gpm)
elec (type power)
 - (7) electric log No (yes or no)
No (organization running log)
 - (8) how well bottom plugged B.W. Valve


CODED

DRILLERS REMARKS:

MAY 23 1974

If well telescopes please sketch and show depths.

GROUND LEVEL

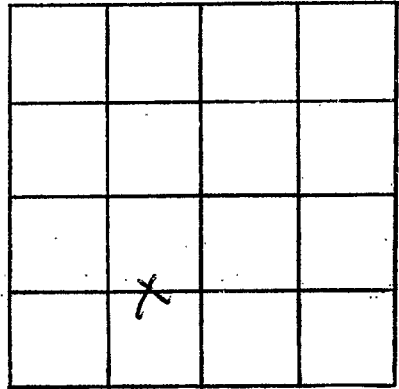

SECTION 9

Please indicate well location X.

ADDITIONAL INFORMATION

If more than one screen,
show locations of each on sketch.