

Pearl River
 M 30
 4-18-75

MISSISSIPPI
 BOARD OF WATER COMMISSIONERS
 416 North State Street
 Jackson, Mississippi 39201

CODED

WATER WELL DRILLERS LOG

4-18 1975 Badintonson Pearl River
 date well completed firm name county well located

LANDOWNER:

Luther Hamell
Rt. 3, Poplarville Miss.
 (mailing address)

description of formations encountered

description of formations encountered	from	to
<u>Red Shale</u>	<u>0</u>	<u>18</u>
<u>Red sand</u>	<u>18</u>	<u>20</u>
<u>Grey shale</u>	<u>20</u>	<u>170</u>
<u>White sand</u>	<u>170</u>	<u>185</u>
<u>Grey shale</u>	<u>185</u>	<u>250</u>
<u>White sand</u>	<u>250</u>	<u>295</u>

WELL LOCATION:

sec. 6 T 3 N R 15 E 13V
31 miles S of Poplarville
 (distance) (direction) (nearest town)

WELL PURPOSE: Home
 (home, irrigation, municipal, industrial)

WELL COMPLETION DATA:


- (1) diameter (inches) 4 in
- (2) total depth (feet) 295
- (3) static water level (feet) 149 below top of ground
- (4) casing PVC 285
 (material) (depth)
- (5) screen 4 1/2 285
 (length) (depth to top)
12 PVC
 (size) (material)
- (6) pump 1 650
 (HP) (yield gpm)
Electric
 (type power)
- (7) electric log NO
 (yes or no)
- (8) how well bottom plugged hard shut

DRILLERS REMARKS:

RECEIVED
 JUN 23 1975

If well telescopes please sketch and show depths.

GROUND LEVEL

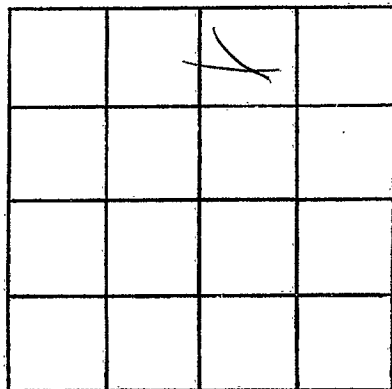

SECTION _____

Please indicate well location X.

ADDITIONAL INFORMATION

If more than one screen,
show locations of each on sketch.