

Pearl River
M 31
4-10-75

MISSISSIPPI
 BOARD OF WATER COMMISSIONERS
 416 North State Street
 Jackson, Mississippi 39201

CODED

WATER WELL DRILLERS LOG

4-10 1975 Bud Renter & Son Pearl River
 date well completed firm name county well located

LANDOWNER:
Norman D. Gerald
Rt. 3, Poplarville, Miss.
 (mailing address)


| description of formations encountered | from | to |
|---------------------------------------|------------|------------|
| <u>Red Shale</u> | <u>0</u> | <u>60</u> |
| <u>White sand</u> | <u>60</u> | <u>105</u> |
| <u>Grey shale</u> | <u>105</u> | <u>175</u> |
| <u>White sand</u> | <u>175</u> | <u>220</u> |

WELL LOCATION:
 sec. 6 T. 3 N. R. 15 E. ¹³¹
81 miles South of Poplarville
 (distance) (direction) (nearest town)

WELL PURPOSE: Home
 (home, irrigation, municipal, industrial)

- WELL COMPLETION DATA:
- (1) diameter (inches) 2 1/2
 - (2) total depth (feet) 220
 - (3) static water level (feet) 123 below above top of ground.
 - (4) casing PVC 210
 (material) (depth)
 (size) If telescope see back.
 - (5) screen 2x10 210
 (length) (depth to top)
12 PVC
 (size) (material)
 - (6) pump NO pump
 (HP) (yield gpm)
electric
 (type power)
 - (7) electric log _____
 (yes or no)
 (organization running log)
 - (8) how well bottom plugged Red Shale

DRILLERS REMARKS:

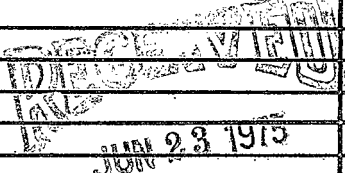

MISS. BD. OF WATER COMMISSIONERS

If well telescopes please
sketch and show depths.

GROUND LEVEL

| | | | |
|--|--|---|--|
| | | X | |
| | | | |
| | | | |
| | | | |

SECTION _____

Please indicate well location X.

ADDITIONAL INFORMATION

| |
|--|
| |
| |
If more than one screen,
show locations of each on sketch.