

Jackson D. Tom place
for additional info
701-80-80

PEARL RIVER
M32
1-18-80

MISSISSIPPI
BOARD OF WATER COMMISSIONERS
416 North State Street
Jackson, Mississippi 39201

CODED
to log # 117

WATER WELL DRILLERS LOG

1-18-80
date well completed

TOM GRIFFITH
PLUMBING & WELL SERVICE, INC.
320 MAYSON AVE.
COLUMBIA, MS 39420

Pearl River
county well located

LANDOWNER:
Center water corp.
(mailing address)

WELL LOCATION:
sec. 11 T. 3 N R. 15 E
4 miles (distance) (direction) of (nearest town)

WELL PURPOSE:
(home, irrigation, municipal, industrial)

WELL COMPLETION DATA:
(1) diameter (inches) 6" x 4"
(2) total depth (feet) 1076 ft
(3) static water level (feet) 214 below top of ground.
(4) casing (material) 1076 ft (depth)
(size) if telescope see back.
(5) screen 45 (length) 1031 (depth to top)
4" top pipe 4" screen (size) (material)
(6) pump 20 (HP) 150 (yield gpm)
Elect (type power)
(7) electric log yes MGS (yes or no)
(organization running log)
(8) how well bottom plugged B-W

description of formations encountered	from	to
top soil	0	20
gravel	20	60
Clay	60	190
gravel & sand	190	310
Clay	310	980
sand	980	1076
6" casing		
4" casing		
14" screen		

DEPT. OF NATURAL RESOURCES
BUREAU OF LAND & WATER RESOURCES

MAR 10 1980


RECEIVED

DRILLERS REMARKS:



If well telescopes please
sketch and show depths.

GROUND LEVEL

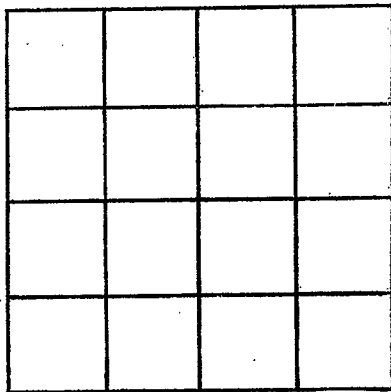

SECTION _____

Please indicate well location X.

ADDITIONAL INFORMATION

If more than one screen,
show locations of each on sketch.