

Pearl River
M 34
10-17-75

MISSISSIPPI
 BOARD OF WATER COMMISSIONERS
 416 North State Street
 Jackson, Mississippi 39201

WATER WELL DRILLERS LOG

10-17 ¹³⁵ 1975 Lempke Well Ser. Pearl River
 date well completed firm name county well located

LANDOWNER:
Mr. Bill Winborn
Paplarville, Miss.
 (mailing address)

description of formations encountered	from	to
	Clay	0
Sand	40	80
Clay	80	100
Sand	100	125
Clay	125	250
Sand	250	305

WELL LOCATION:
 sec. 5 T. 3 N. R. 15 E
2 miles SE of Paplarville
 (distance) (direction) (nearest town)

WELL PURPOSE: None
 (home, irrigation, municipal, industrial)


- WELL COMPLETION DATA:
- (1) diameter (inches) 4"
 - (2) total depth (feet) 305
 - (3) static water level (feet) 180' below top of ground.
 - (4) casing P.V.C., 295'
 (material) (depth)
4" If telescope see back.
 (size)
 - (5) screen 10, 295
 (length) (depth to top)
4", P.V.C.
 (size) (material)
 - (6) pump 1 1/2, 15
 (HP) (yield gpm)
Elec.
 (type power)
 - (7) electric log No.
 (yes or no)
No.
 (organization running log)
 - (8) how well bottom plugged Sand Shale

DRILLERS REMARKS:

RECEIVED
 OCT 24 1975
 MISS. Bd. OF WAT

If well telescopes please sketch and show depths.

GROUND LEVEL

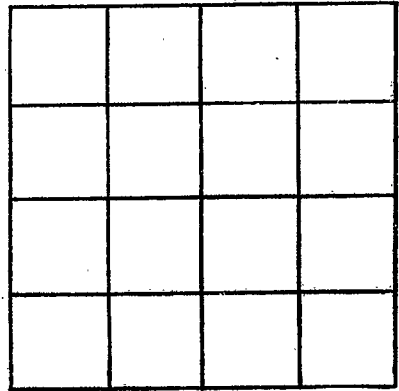

SECTION _____

Please indicate well location X.

ADDITIONAL INFORMATION

If more than one screen, show locations of each on sketch.