

Pearl River

MISSISSIPPI DEPARTMENT OF NATURAL RESOURCES

Bureau of Land and Water Resources

Southport Mall

P.O. Box 10631

Jackson, Mississippi 39209

WATER WELL DRILLERS LOG

CODED

Jackson M35  
copy 1/31/84

1-31 1984 date well completed  
McNeil Well Works Inc. firm name  
Pearl River county well located

LANDOWNER: Ms. Forestry Comm  
Rt. 2 Box 18 Hwy 49-5  
Wiggins Miss.  
(mailing address)

WELL LOCATION: Poplarville  
sec. 14 T 2 N R 15 E  
21 30  
5 miles S.E. of Poplarville  
(distance) (direction) (nearest town)

WELL PURPOSE: Home  
(home, irrigation, municipal, industrial)

WELL COMPLETION DATA: 2734"  
6712"

- (1) diameter (inches) 2" x 4
- (2) total depth (feet) galvanize 340
- (3) static water level (feet) 160' below top of ground.
- (4) casing gal. 320' (material) (depth)
- (5) screen 20' (length) (depth to top)  
2" Stainless Steel (size) (material)
- (6) pump 2 HP. 20 (HP) (yield gpm)  
Electric (type power)
- (7) electric log NO (yes or no)
- (8) how well bottom plugged sand Shark

description of formations encountered	depth	
	from	to
mud	0	20
mud.	20	40
sand	40	100
mud - sand	100	120
mud	120	200
sand	200	220
CODED sand	225	260
sand	260	300
course sand	300	340
Bilbo tower		
SESE elev. 315'		

DEPT. OF NATURAL RESOURCES  
BUREAU OF LAND & WATER RESOURCES  
JACKSON, MISSISSIPPI


FEB 3 1984  
RECEIVED

DRILLERS REMARKS: On app. for a electric log was made in advance. They broke the app. 1 hr. before time to come. we couldn't

hold the hole open. Had to set well or lose well.

If well telescopes please sketch and show depths.

GROUND LEVEL

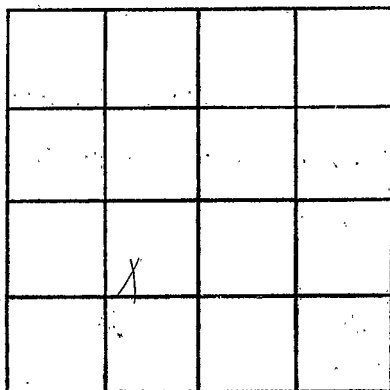

SECTION 19

Please indicate well location X.

ADDITIONAL INFORMATION

If more than one screen, show locations of each on sketch.