

MISSISSIPPI DEPARTMENT OF NATURAL RESOURCES

Bureau of Land and Water Resources

Southport Mall

P.O. Box 10631

CODED

BUD PENTON & SONS

Jackson, Mississippi 39209

WATER WELL DRILLERS & LOG

Rt. 4, Box 402

Waterloo, Mississippi 39096

Waterloo, Mississippi 39096 county well located

Rt. 4, Box 402

Jackson, Mississippi 39209

Phone 800-985-3374

Pearl River
M 38
8/16-85

8/16

1985

BUD PENTON & SONS

Pearl River

date well completed

LANDOWNER: *Big Springs Cattle Co.*

Jackson, Mississippi 39209

Phone 800-985-3374

from to

cattle co. Rt. 4, Box 324

Red Shale

0110

Box 324 Pearl River Miss (mailing address)

Blue Shale

140 264

Top Sand

264 300

WELL LOCATION:

sec 16 T 3 N R 16 E

6 miles *East* of *Apple Hill*

WELL PURPOSE: (home, irrigation, municipal, industrial)

WELL COMPLETION DATA:

- (1) diameter (inches) 4
- (2) total depth (feet) 300
- (3) static water level (feet) 173 below top of ground.
- (4) casing PVC, 300, (material) (depth)
- no if telescope see back. (size)
- (5) screen 4x20, 280 (length) (depth to top)
- 12, PVC (size) (material)
- (6) pump 1 1/2 (HP) 1360 (yield gpm)
- Elect (type power)
- (7) electric log no (yes or no)

(organization running log)

(8) how well bottom plugged *shale*


DRILLERS-REMARKS:

RECEIVED
NOV 20 1985

Department of Natural Resources
Bureau of Land & Water Resources

If well telescopes please sketch and show depths.

GROUND LEVEL

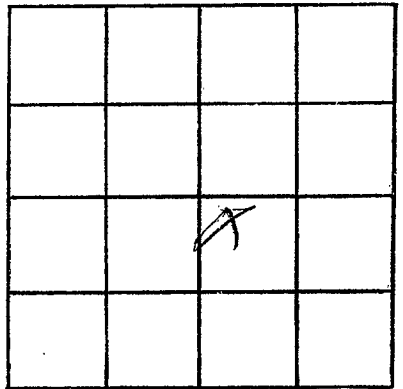

SECTION _____

Please indicate well location X.

ADDITIONAL INFORMATION

If more than one screen,
show locations of each on sketch.